


T. 40S., R. 14W., W. M.

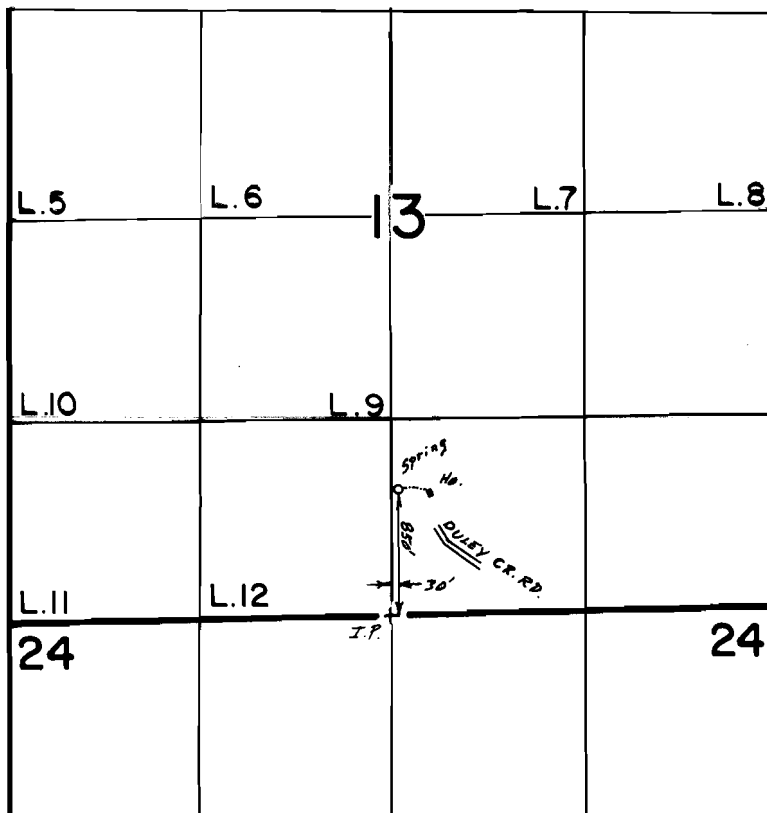

Scale 1"=1320'

FINAL PROOF SURVEY
UNDER

Application No. 56808 Permit No. 42592.....
IN NAME OF

ROY E. & LUETTA M. MILLER

Surveyed Sept. 4 1987, by J.M. SCHMORDE