


T.19S.R.1W., W.M.

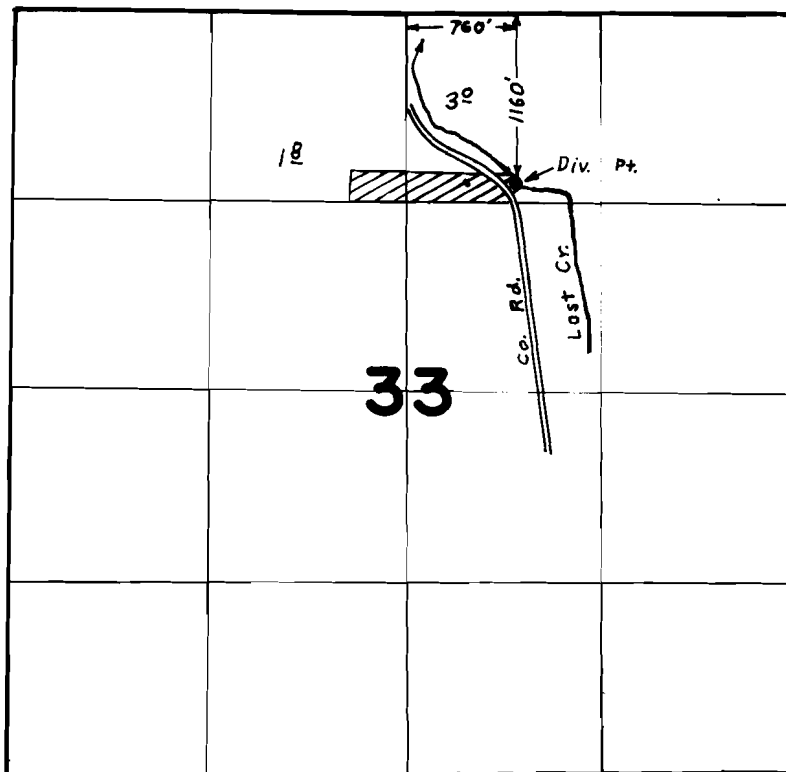

**FINAL PROOF SURVEY**  
UNDER

Application No. 57244... Permit No. 42998....  
IN NAME OF

.....STANLEY SMITH.....

Surveyed SEP 11..... 1978., by J.S.DONALDSON