




T. 23 S., R. 12 W., W.M.

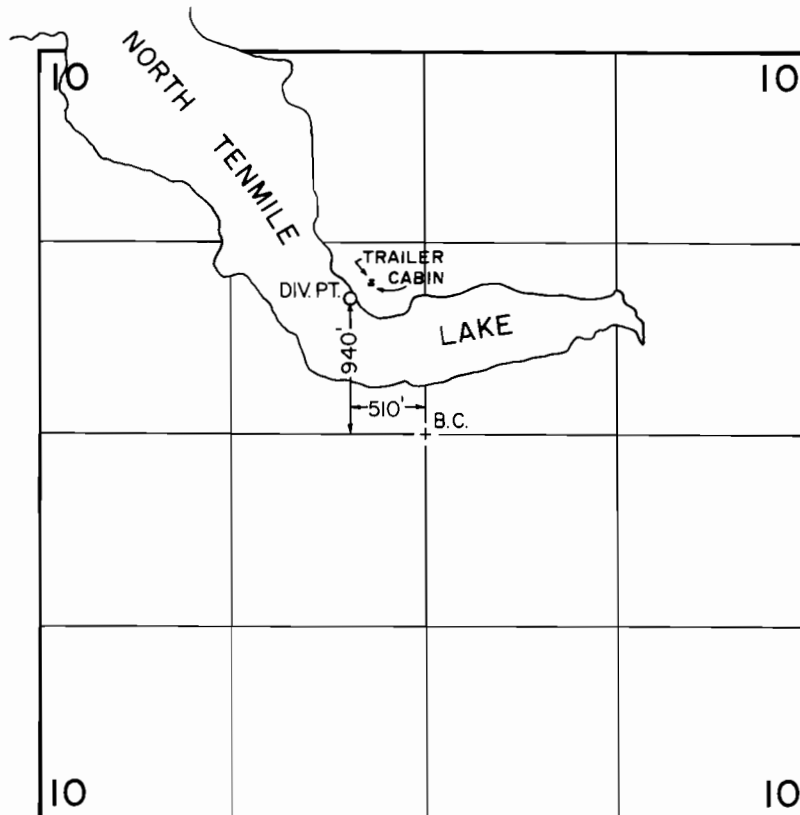

SCALE: 1" = 1320'

FINAL PROOF SURVEY
UNDER

Application No. 57821 Permit No. 43599
IN NAME OF

PHILLIP GOETSCHALCKX

Surveyed SEPT. 20 1988, by T. M. WARREN