


T.13S.,R.30E.,W.M.

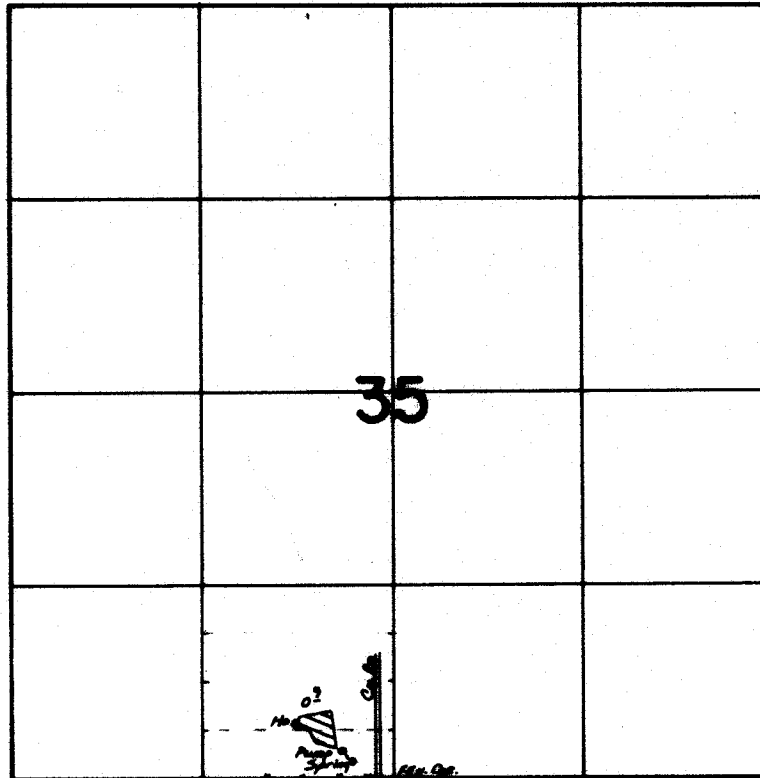

Spring Loc: 120 Ft. N AND 280 Ft. W FROM 3/4 COR. Sec. 35

Scale: 1" = 1320'

FINAL PROOF SURVEY UNDER

Application No. 57496.. Permit No. 43722.....

IN NAME OF
NEIL DUTTON
MARVIN L. & VELMA E. KINSEY.....

Surveyed Sept. 14, 1983, by R. W. Cattel.....
& June 17 1988, by T. Warren