


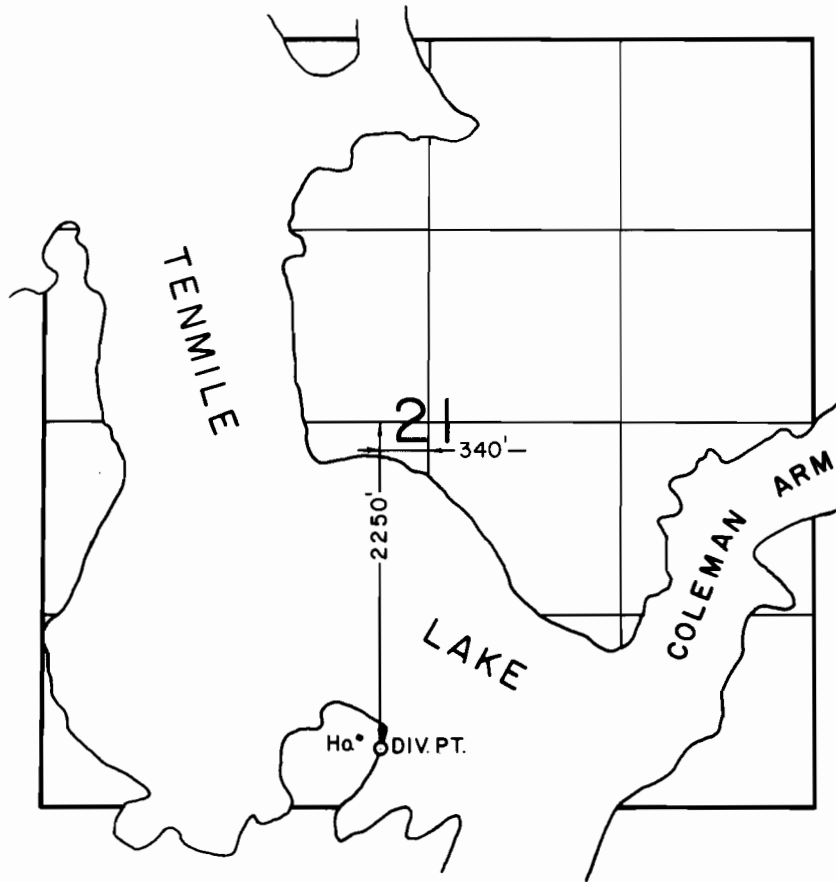

T. 23 S., R. 12 W., W.M.



SCALE: 1" = 1320'

FINAL PROOF SURVEY
UNDER

Application No. 58109... Permit No. 43804....
IN NAME OF

Dr. ALAN L. WHITNEY

Surveyed SEPT. 21, 1988, by T. M. WARREN.