


T. 31 S., R. 4 W., W.M.
SECTION 33

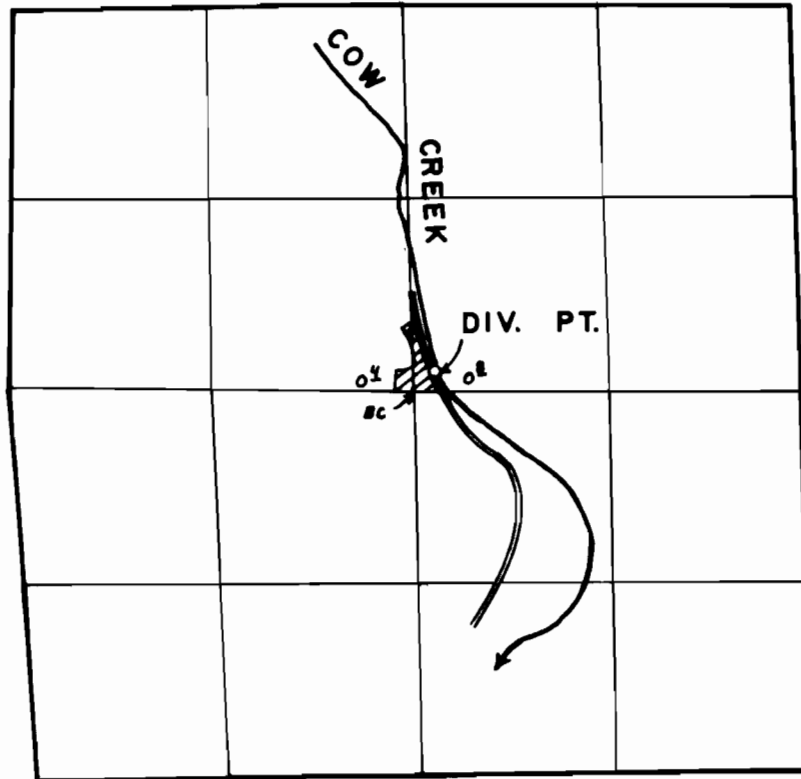

Div. Pt. is located 140' N. and 150' E. of
the center of Section 33.

SCALE: 4" = 1 mile

FINAL PROOF SURVEY
UNDER

Application No. 58066 Permit No. 44016....
IN NAME OF

WILLIAM D. WADE

Surveyed NOV...23 19.83, by *J. E. Cashion*