


T. 17 S., R. 2 W. W.M.

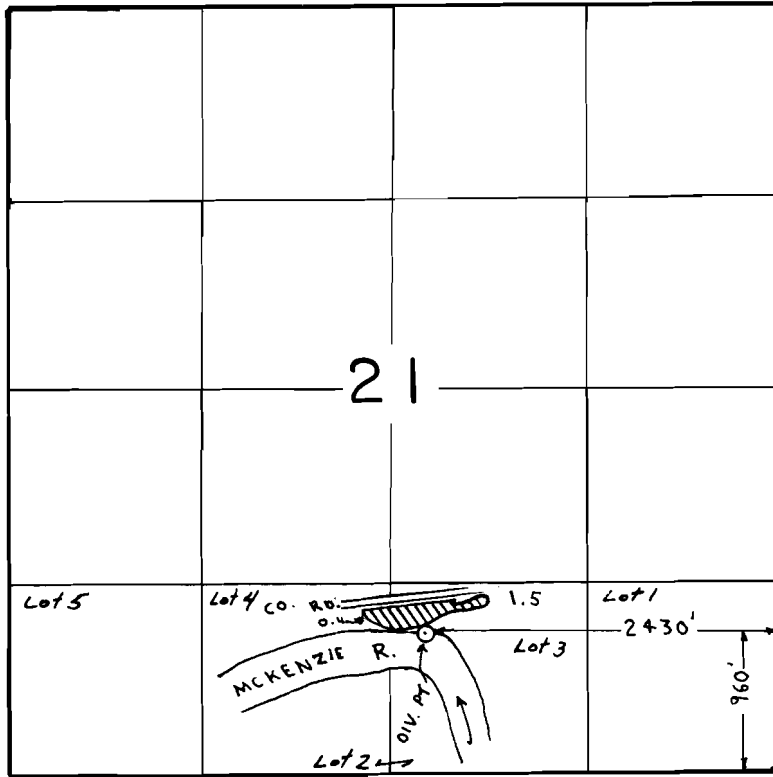

**FINAL PROOF SURVEY**  
UNDER

Application No. 58520... Permit No. 44097.....  
IN NAME OF

...ROBERT B. OSBORNE.....

Surveyed NOV. 14, 1983, by P. PAGTER.....