


T. 13S., R. 5W., W.M.

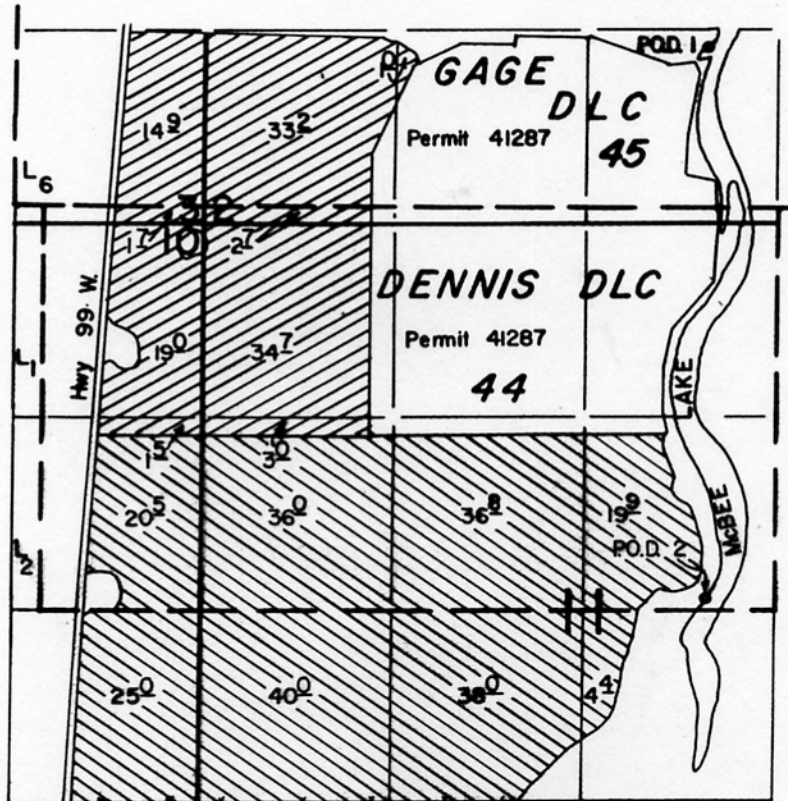

P.O.D. 1 Loc.: 1120' N. & 490' W. from NE Cor. DLC 44
 P.O.D. 2 Loc.: 70' N. & 480' W. from SE Cor. DLC 44

Scale: 1" = 1320'

FINAL PROOF SURVEY
 UNDER

Application No. 58723... Permit No. 44664.....
 IN NAME OF

.....VENELL FARMS, INC.....

Surveyed AUG. 25. 1988., by T.M. Warren.....