


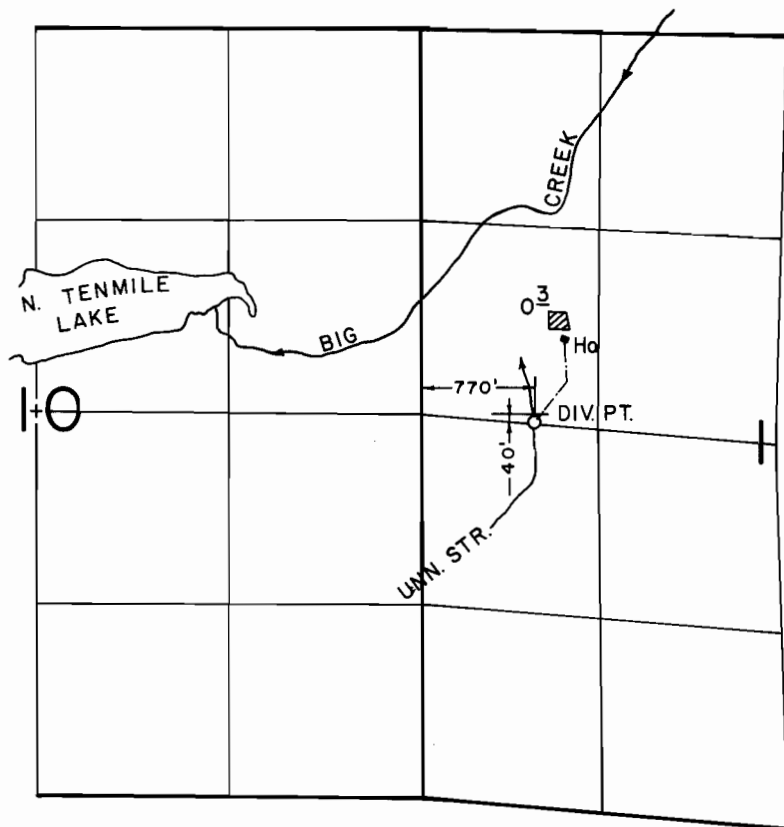

T.23 S., R.12 W., W.M.



SCALE: 1" = 1320'

FINAL PROOF SURVEY UNDER

Application No. 59320 Permit No. 44709
IN NAME OF

KATHY & HARVEY WILCOX

Surveyed SEPT. 18, 1988, by T. M. WARREN