


T. 14 S., R. 8 W., W.M.

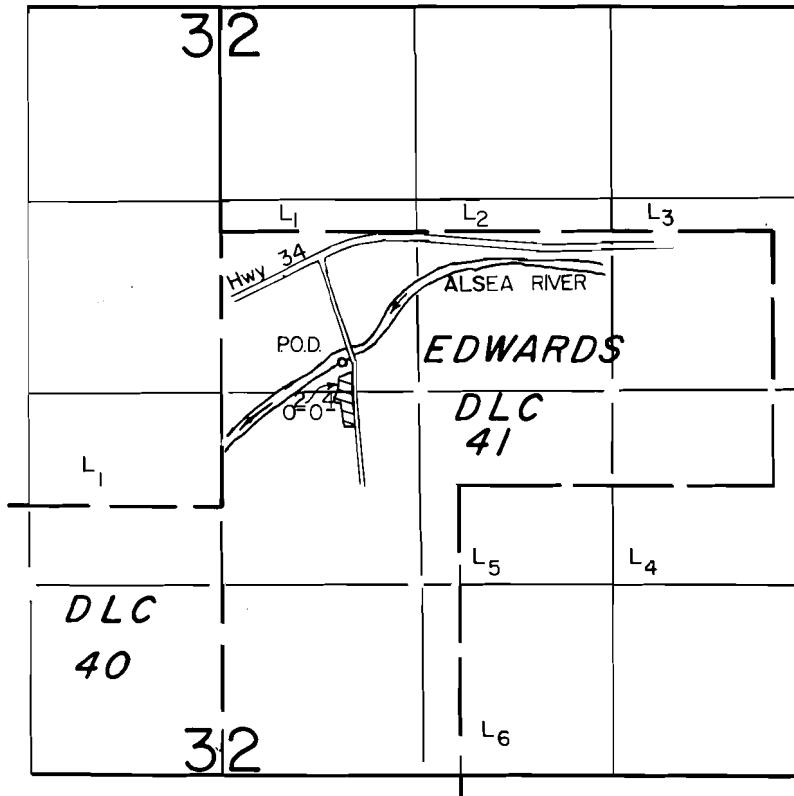

P.O.D. Loc. : 900' S. & 830' E. from NW Cor. DLC 41.

Scale : 1" = 1320'

FINAL PROOF SURVEY
UNDER

Application No. 58891..... Permit No. 44935.....

IN NAME OF

LEON DOUGLAS COLGAN

Surveyed Oct. 26, 1987, by T. Warren