




T. 23 S., R. 12 W., W.M.

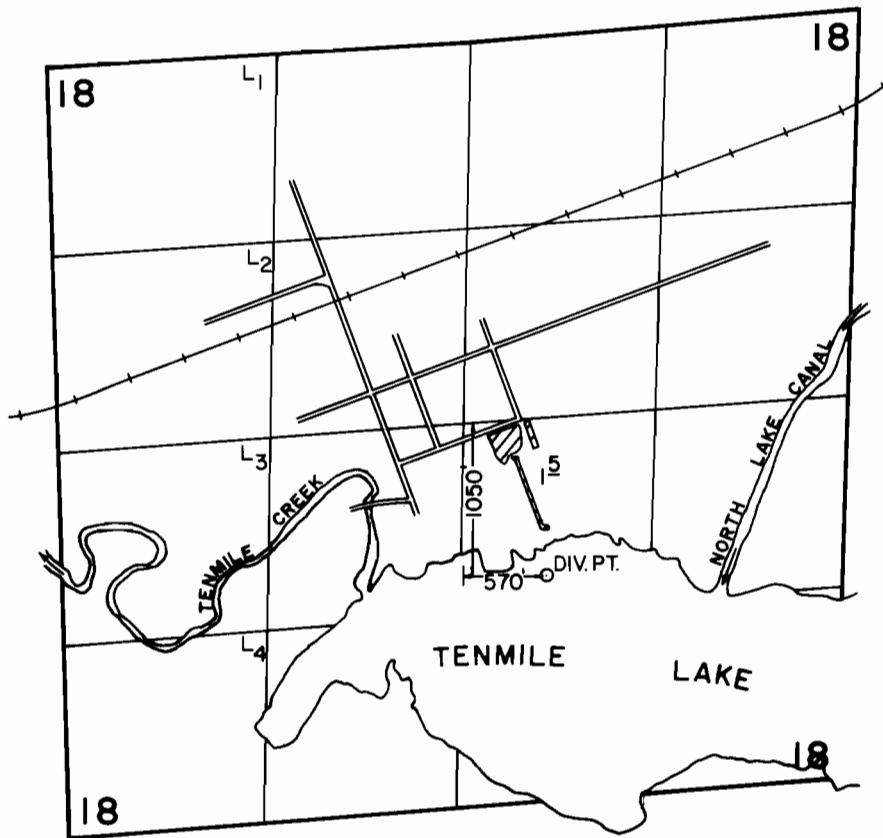

SCALE: 1" = 1320'

FINAL PROOF SURVEY
UNDER

Application No. 60435. Permit No. 44997.....
IN NAME OF

COOS COUNTY PARKS DEPARTMENT

Surveyed SEPT. 19, 1988, by L. M. JOACHIMS