


T.4S. R.4W. W.M.

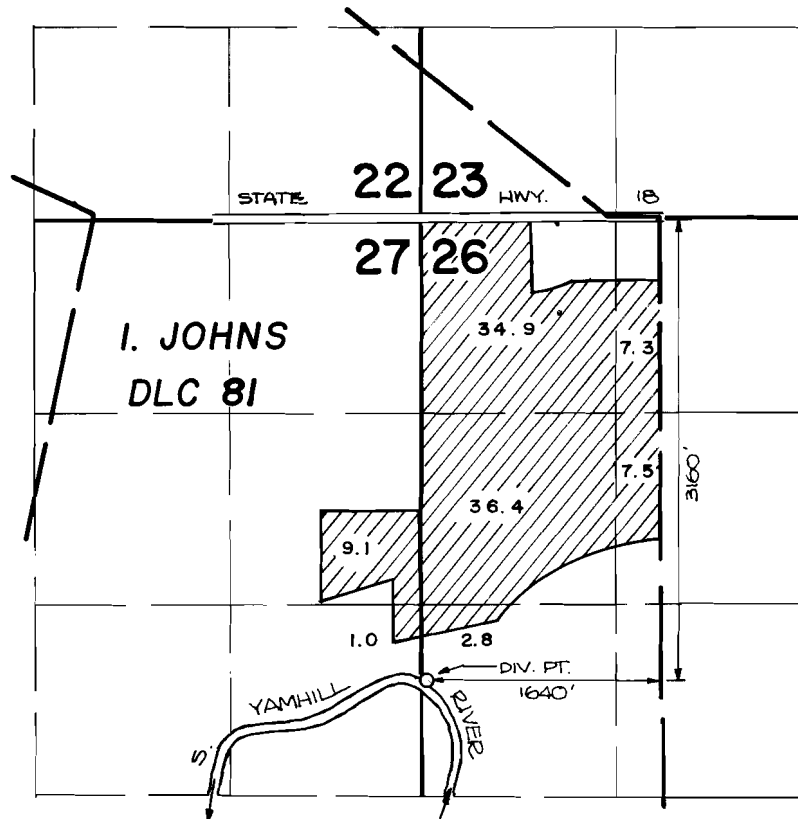

**FINAL PROOF SURVEY
UNDER**

Application No. ~~59933~~ Permit No. ~~45020~~

IN NAME OF

IVAN BERNARDS

Surveyed OCT. 3 1983 by P. Patten