


# T.11S.,R.2W.,W.M.

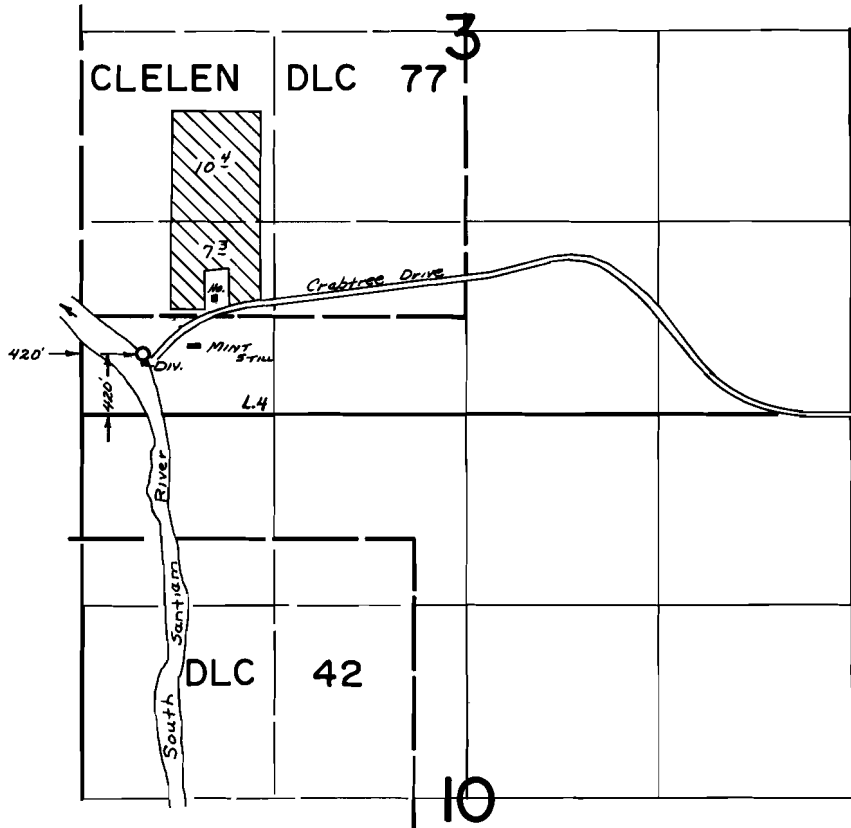

## FINAL PROOF SURVEY UNDER

Application No. .59949. Permit No. .45024.....  
IN NAME OF

.....**BOB SHUMAKER**.....

Surveyed Aug...7... 19.8.l., by ...L...TOLL.....