


T. 17 S., R. 2 W., W.M.

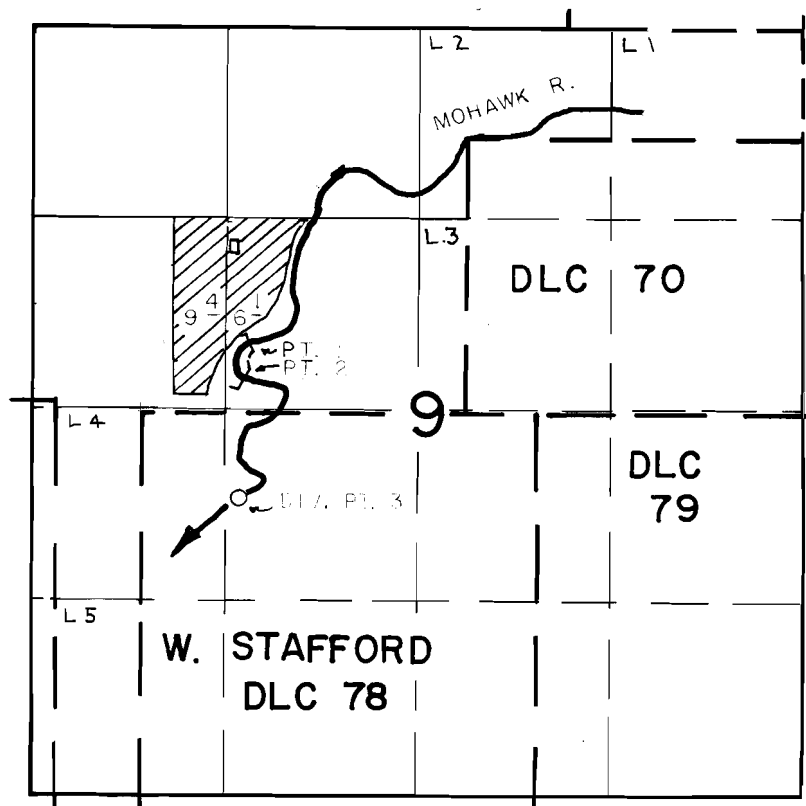

PORTABLE PUMPING BETWEEN PT. 1 LOC. 500' N & 720' E.  
AND PT. 2 LOC. 220' N & 670' E. D.V. PT. 3 570' S &  
650' E. OF NW COR. DLC 78

## FINAL PROOF SURVEY UNDER

Application No. 60050.. Permit No. 45028.....  
IN NAME OF

CARL E. GATEWOOD

Surveyed JUL 18, 1984, by P. PAGTER