


T.13S.,R.31E.,W.M.

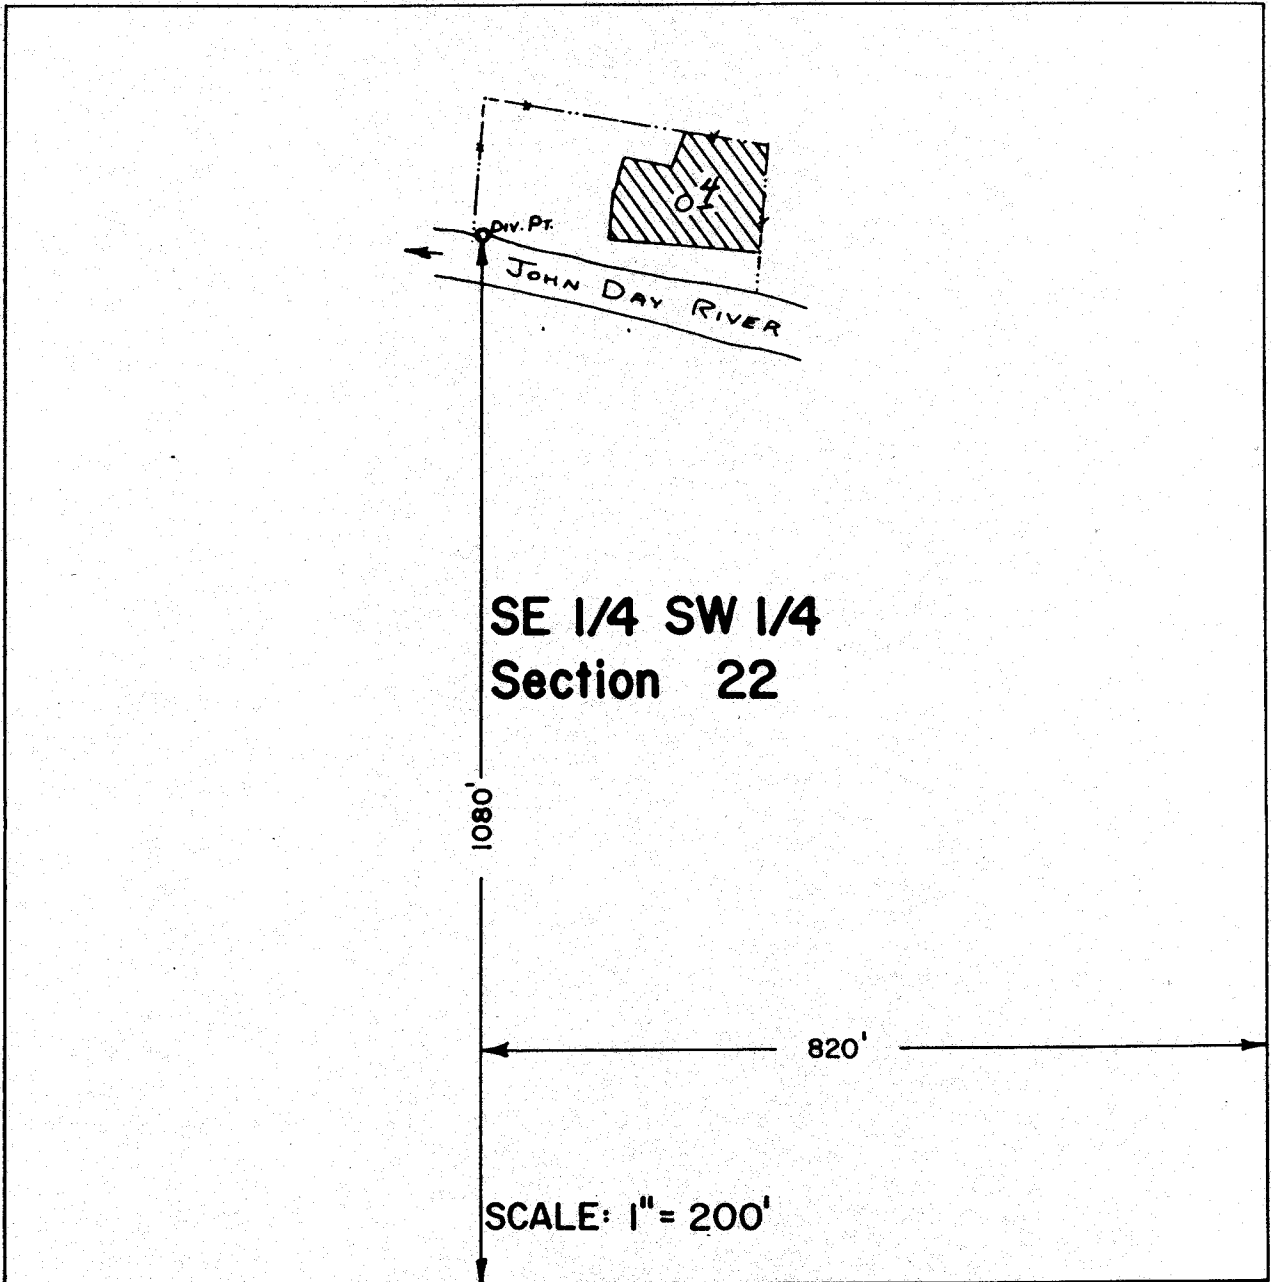

FINAL PROOF SURVEY
UNDER

Application No. .59931... Permit No. .45041.....
IN NAME OF

.....**ROBERT LLOYD PEREIRA**.....

Surveyed July...20... 19.83., by .R..W..Cettel.....