


P-45045  
C-61933

# T.13S.,R.31E.,W.M.

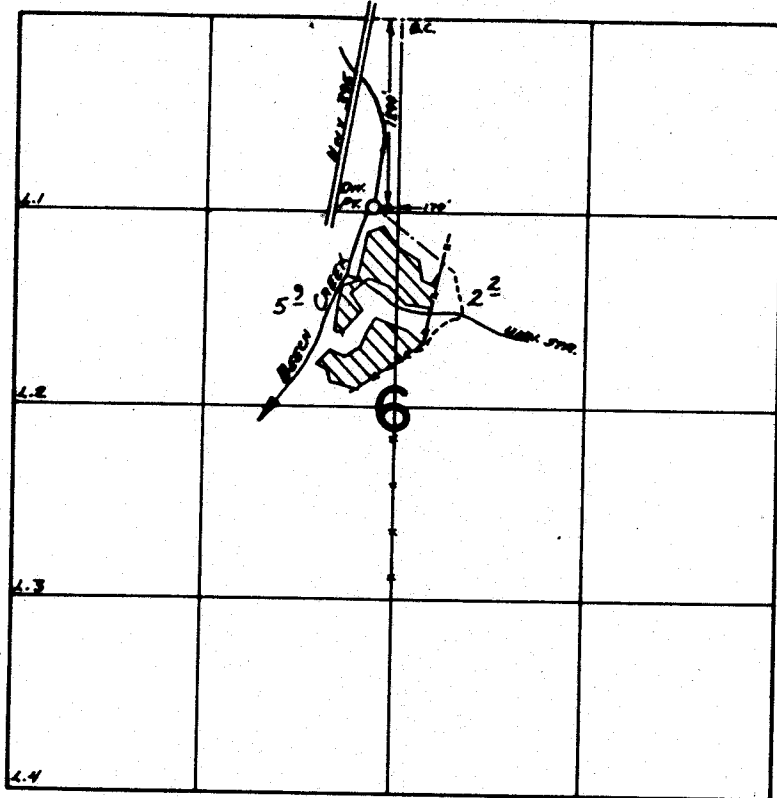

## FINAL PROOF SURVEY UNDER

Application No. .60120... Permit No. .45045.....  
IN NAME OF

.....FRED WINEGAR.....

Surveyed Aug....9... 19.83., by ..R.W.Cettel.....