


T. 35 S., R. 5 W., W.M.

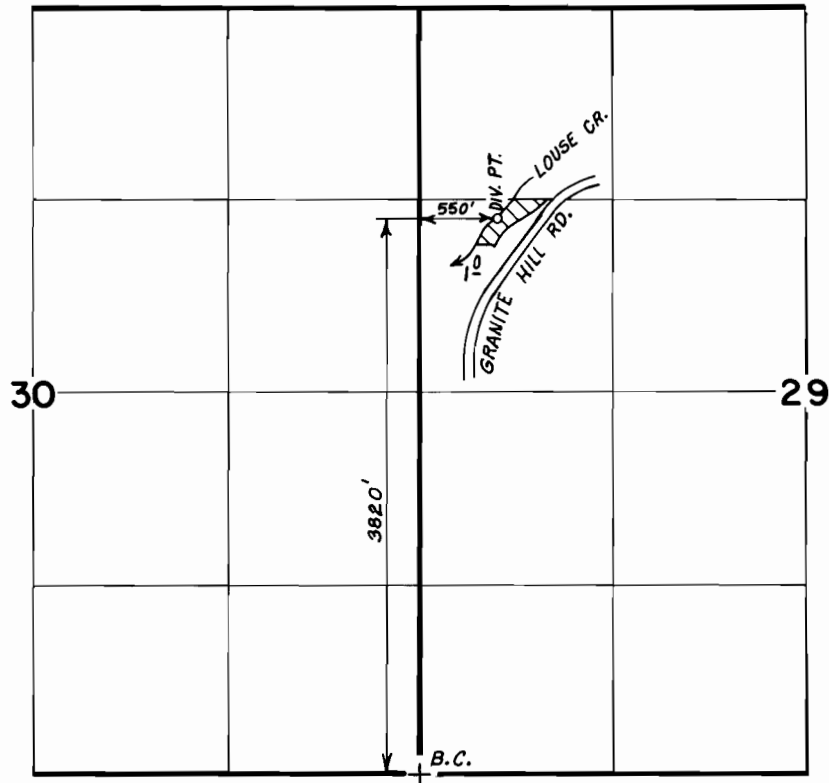

SCALE: 1" = 1320'

FINAL PROOF SURVEY
UNDER

Application No. **60085** Permit No. **45066**...
IN NAME OF

THOMAS H. TAYLOR

Surveyed **JULY 10, 1984**, by **B. S. JAMES**...