


T.26S.,R.6W.,W.M.

Section 27

NE 1/4 NE 1/4

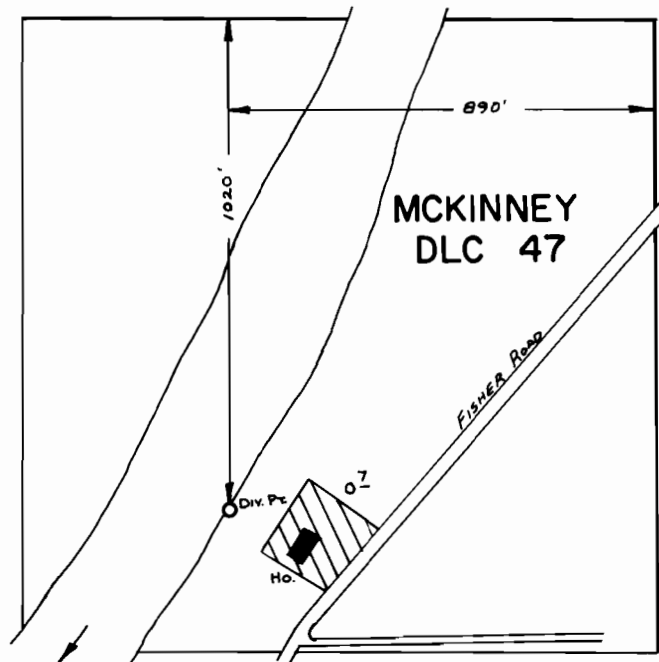

SCALE: 1" = 400'

FINAL PROOF SURVEY
UNDER

Application No. 60118... Permit No. 45077....
IN NAME OF

VICTOR U. BUENZLE

Surveyed July 22, 1982, by L.M. TOLL