


T. 1 N., R. 45 E., W. M.

SCALE: 1"=1320'

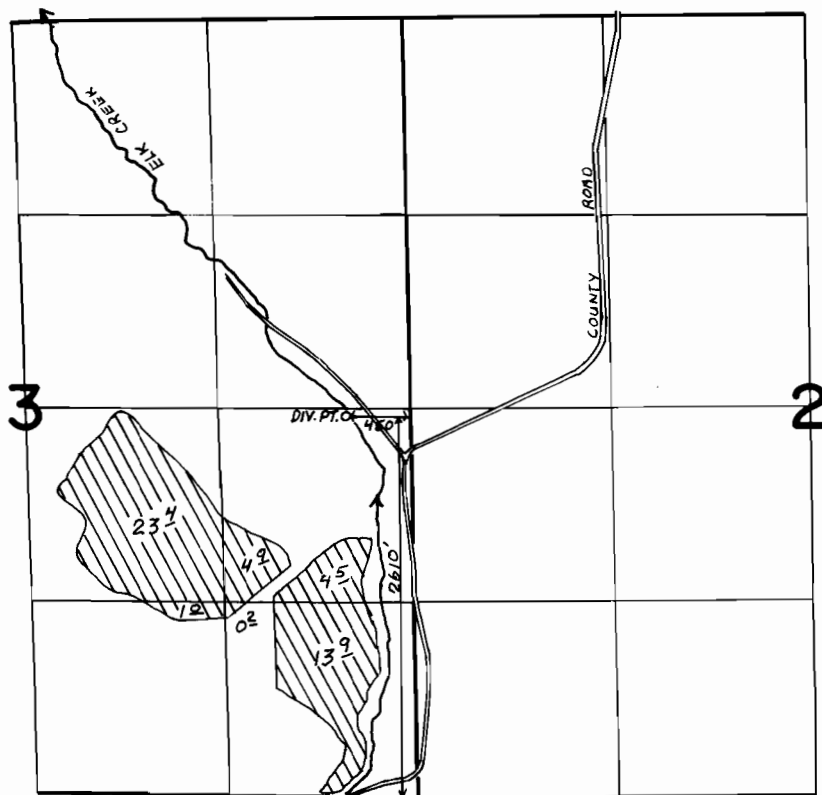

FINAL PROOF SURVEY
UNDER

Application No. 60233... Permit No. 45111.....

IN NAME OF

M & N RANCH

Surveyed Aug. 14..... 1985., by V. L. CHURCH.....