


T. 37 S., R. 6 W., W.M.

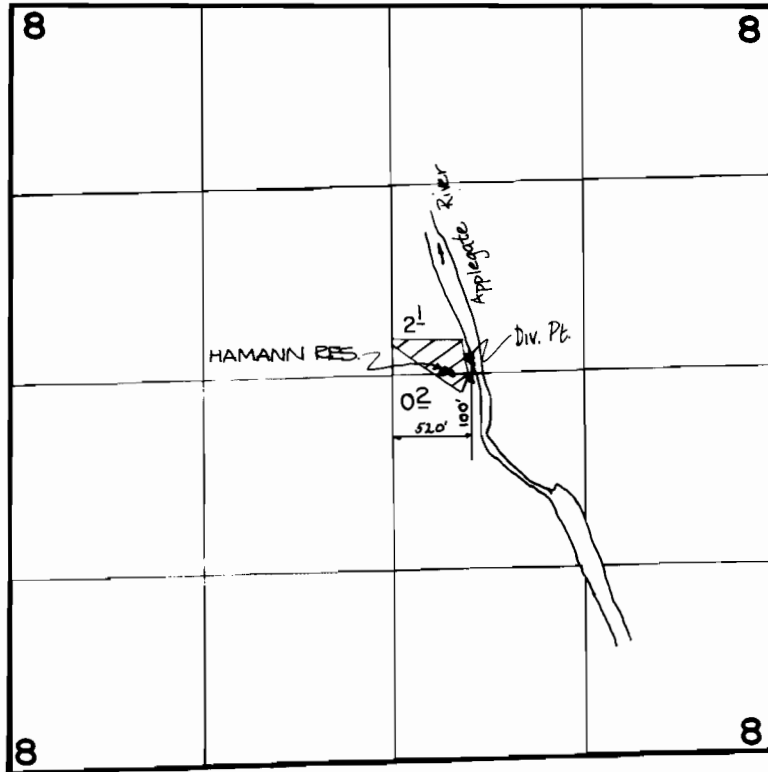

FINAL PROOF SURVEY UNDER

62198 46076
Application No. 60234 Permit No. 45130.....
IN NAME OF

DALE B. & EURETHA M. HAMANN

Surveyed OCT. 17, 1983, by B.S. JAMES.....