


23, T.37 S., R.6 W

Scale 1"=400' June, 1980

Dale B & Euraetha Hamann

45130
↑
N

Application No. 60-434
Permit No. 45130

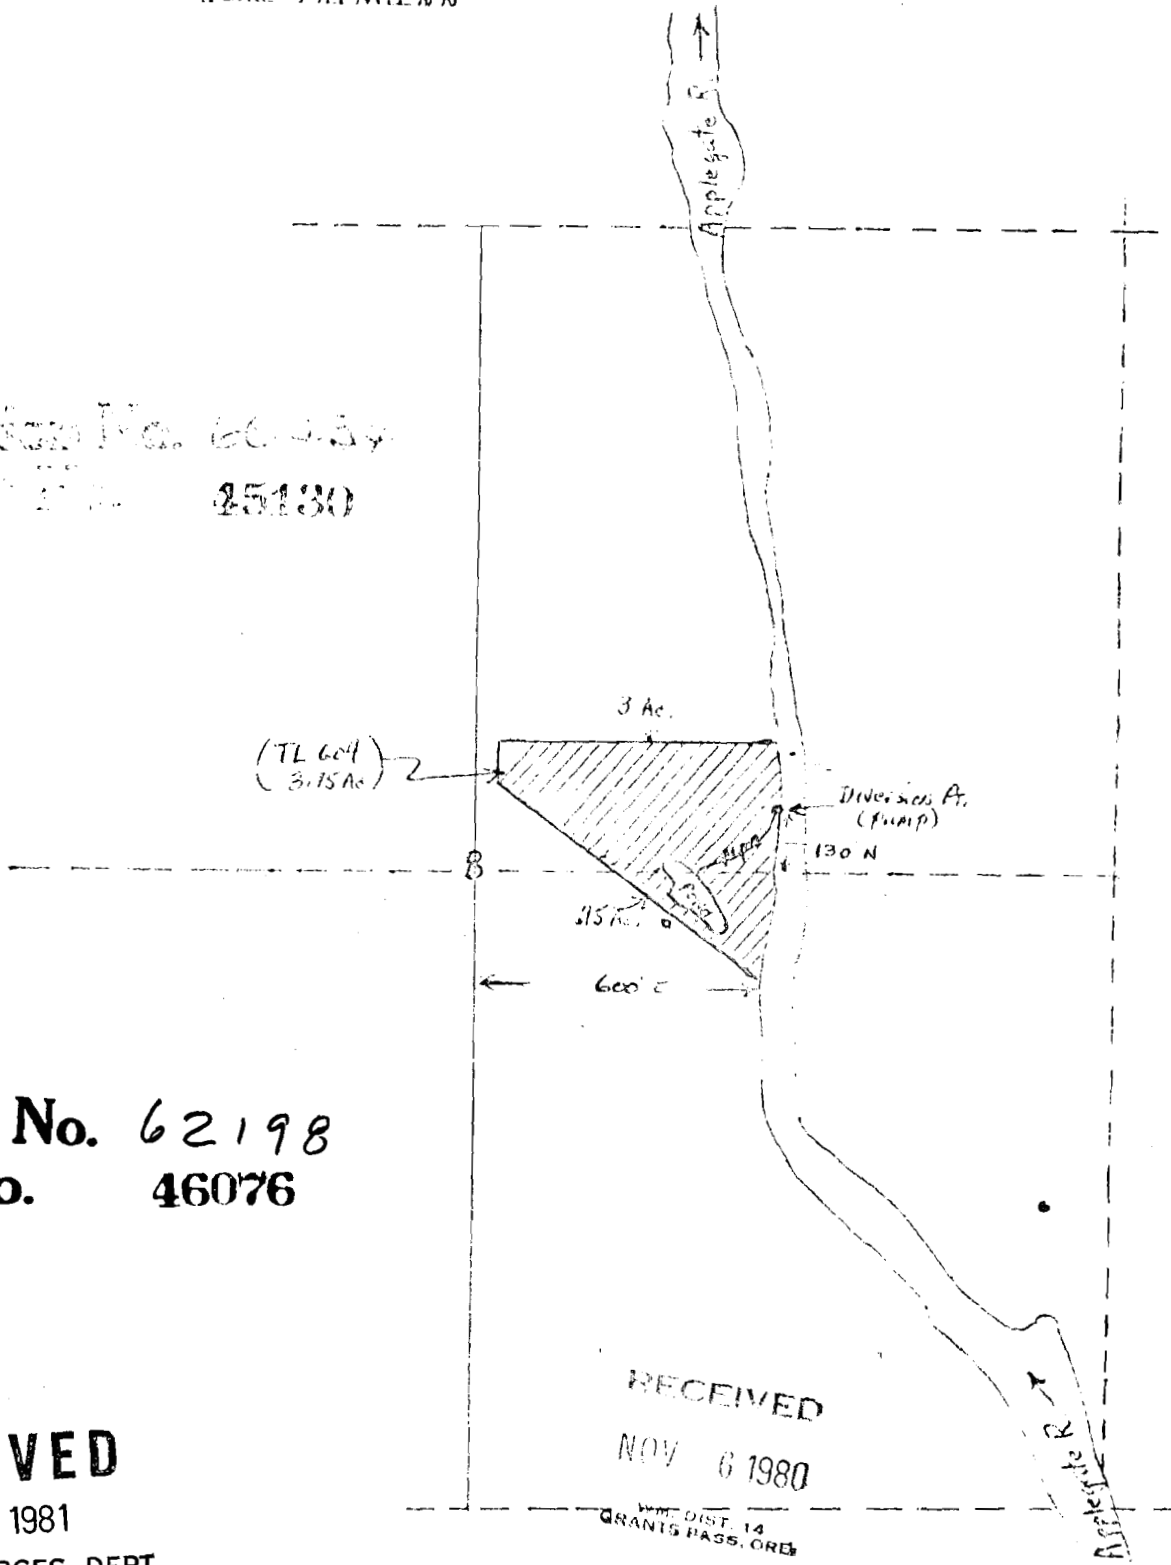

Application No. 62198
Permit No. 46076

RECEIVED

AUG 10 1981

WATER RESOURCES DEPT
SALEM, OREGON

RECEIVED

NOV 6 1980

WATER DIST. 14
GRANTS PASS, OREG.