


T.27S., R.6W., W.M.

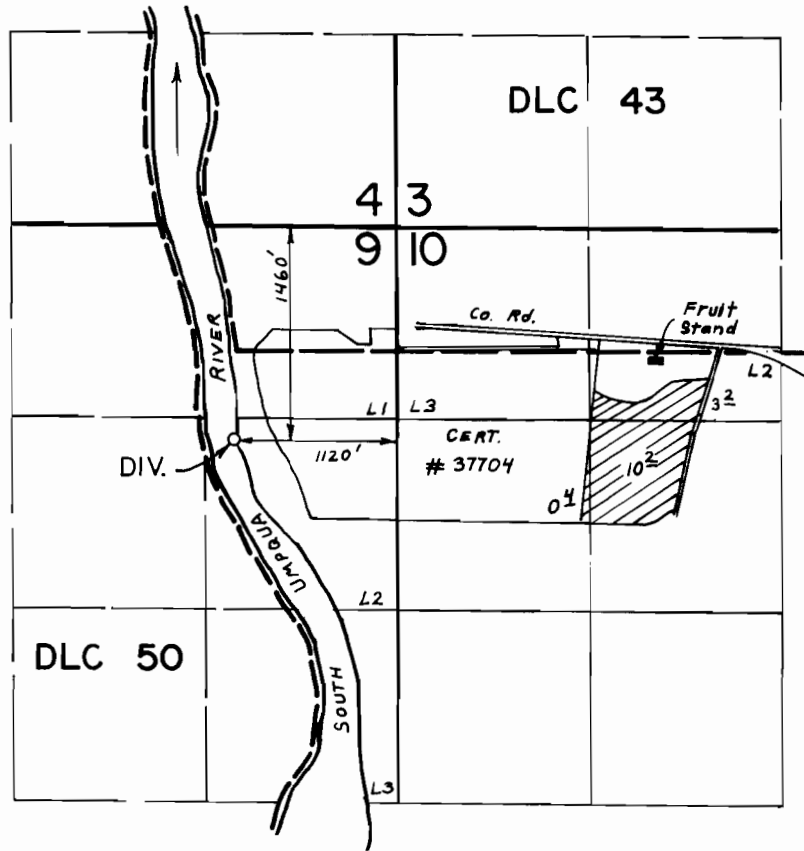

SCALE: 4" = 1 mile

FINAL PROOF SURVEY
UNDER

Application No. 60271... Permit No. 45149.....
IN NAME OF

HAYDEN & ROI JEAN LAURANCE

Surveyed MAY...8... 1984, by *L. Cashman*.....