


T.26S.,R.8W.,W.M.

Section 1

NW 1/4 SE 1/4

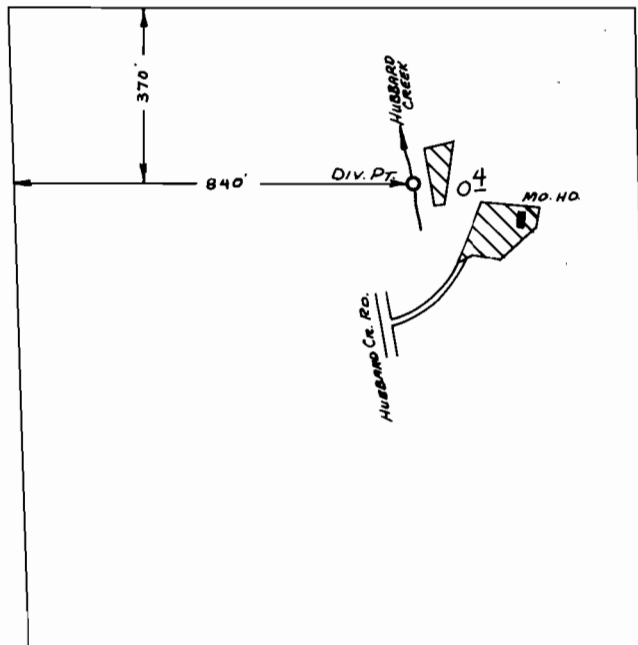

SCALE : 1" = 400'

FINAL PROOF SURVEY
UNDER

Application No. .60367. Permit No. .45158.....
IN NAME OF

WILLIAM H. & FRIEDA C. WAGNER

Surveyed May...11... 1982., by L.M. TOLL.....