


T.19S.,R.1W.,W.M.

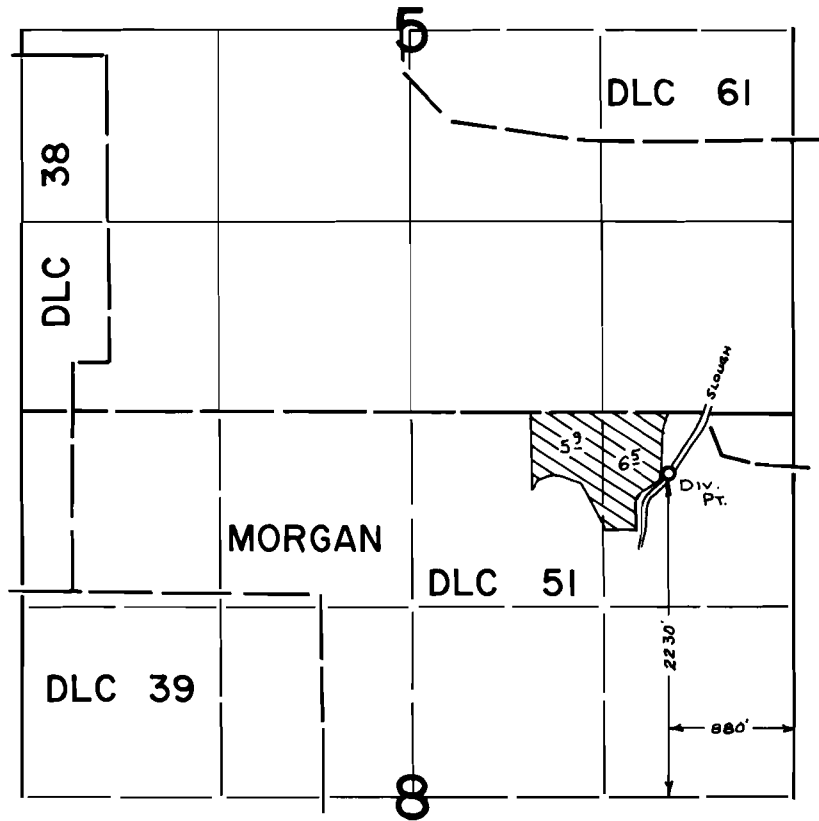

FINAL PROOF SURVEY UNDER

Application No. .60145.. Permit No. .45193.....
IN NAME OF

E...D...M...&...J...INVESTMENT...CO..

Surveyed Aug...3... 1982, by L...M...TOLL.....