


T.26S.,R.6W.,W.M.

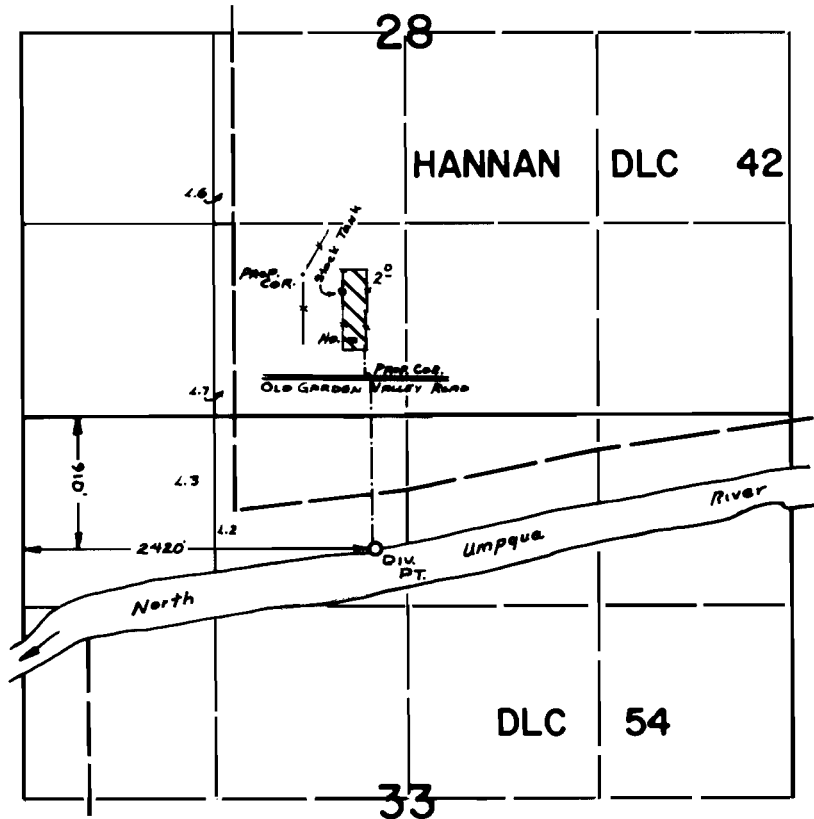

FINAL PROOF SURVEY
UNDER

Application No. 59713 Permit No. 45245
IN NAME OF

HAROLD A. ESSELSTROM

Surveyed June 24, 1982, by L. M. TOLL