


T. 35 S., R. 4 W., W.M.

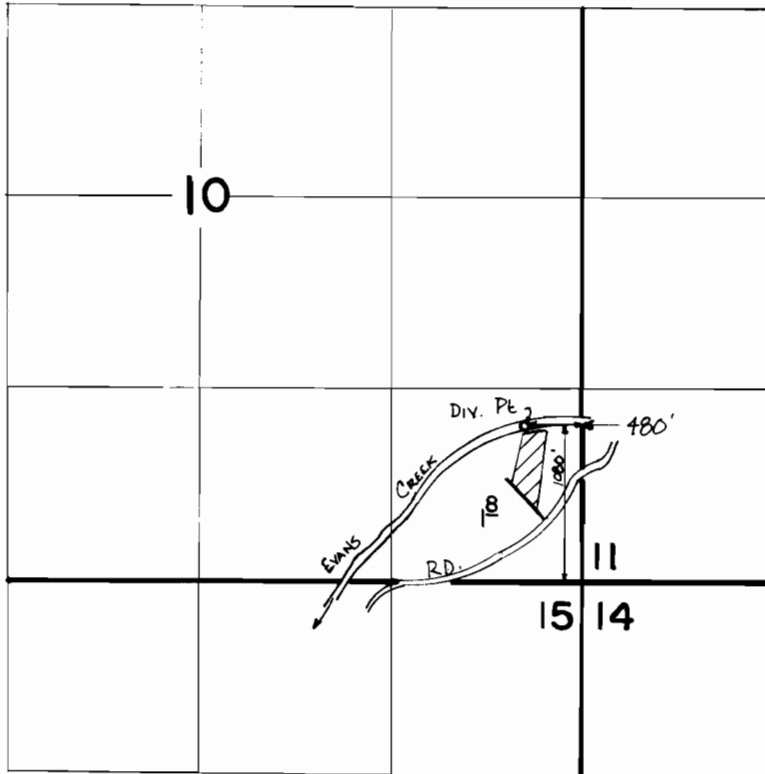

**FINAL PROOF SURVEY**  
UNDER

Application No. 60462 Permit No. 45236.....

IN NAME OF

**FLORENCE MARDELL BLACK**

Surveyed DEC. 12, 1983, by B. S. JAMES.....