


T.27 S., R.6 W., W.M.

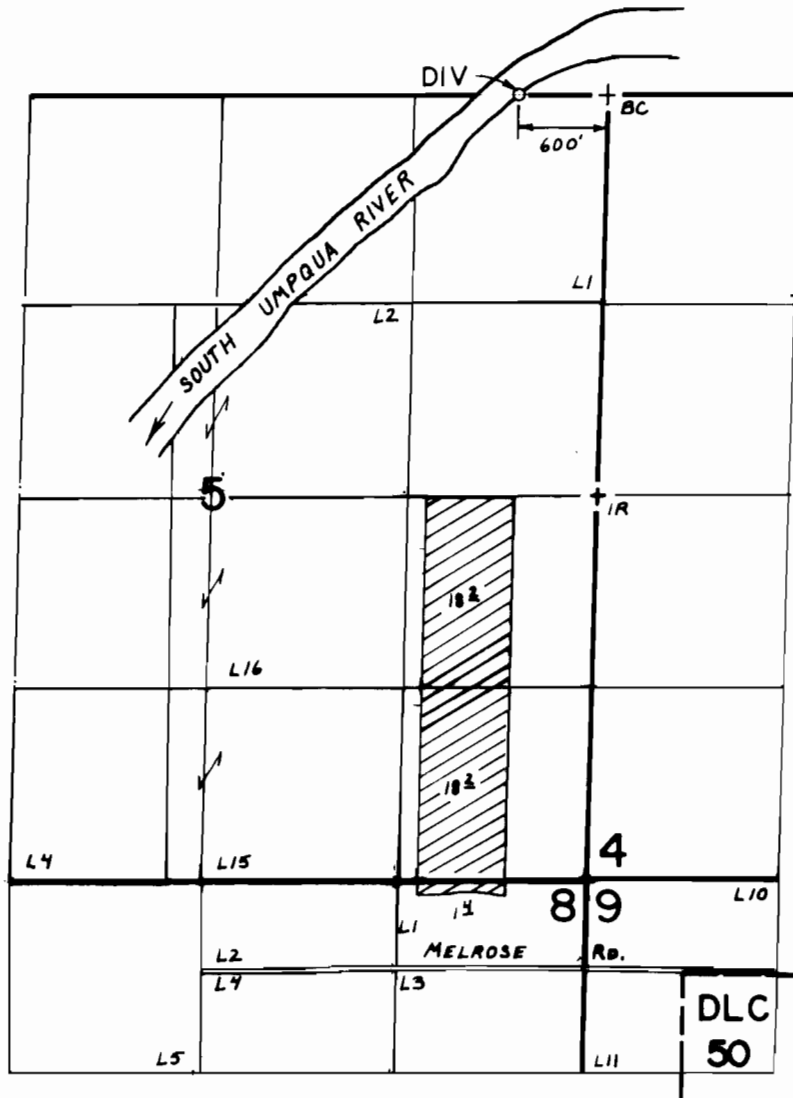

SCALE: 4" = 1 mile

**FINAL PROOF SURVEY**  
UNDER

Application No. 60441... Permit No. 45253.....  
IN NAME OF

**LAURANCE'S GARDENS**

Surveyed MAY 8 1984, by *L. Cashion*

*See 750 AS 670*