


# T. 13S., R. 5W., W.M.

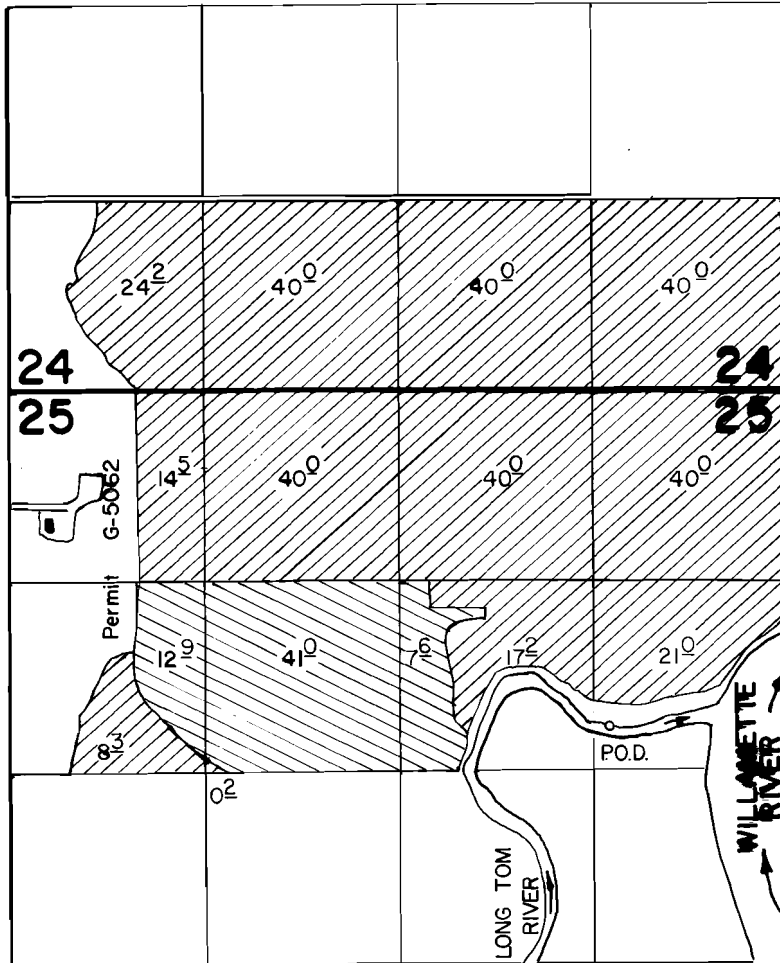


PO.D. Loc.: 2330' S. & 1210' W. from NE Cor. Sec. 25.

Scale: 1" = 1320'

## FINAL PROOF SURVEY UNDER

 Supplemental from Fern Ridge

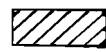 Primary from Fern Ridge & Long Tom River

Application No. 53945. Permit No. 45344  
IN NAME OF

**JOHN, GEORGINA & MICHAEL WAHL**

Surveyed Sept. 21, 1987, by T. Warren