


T.28S.,R.4W.,W.M.

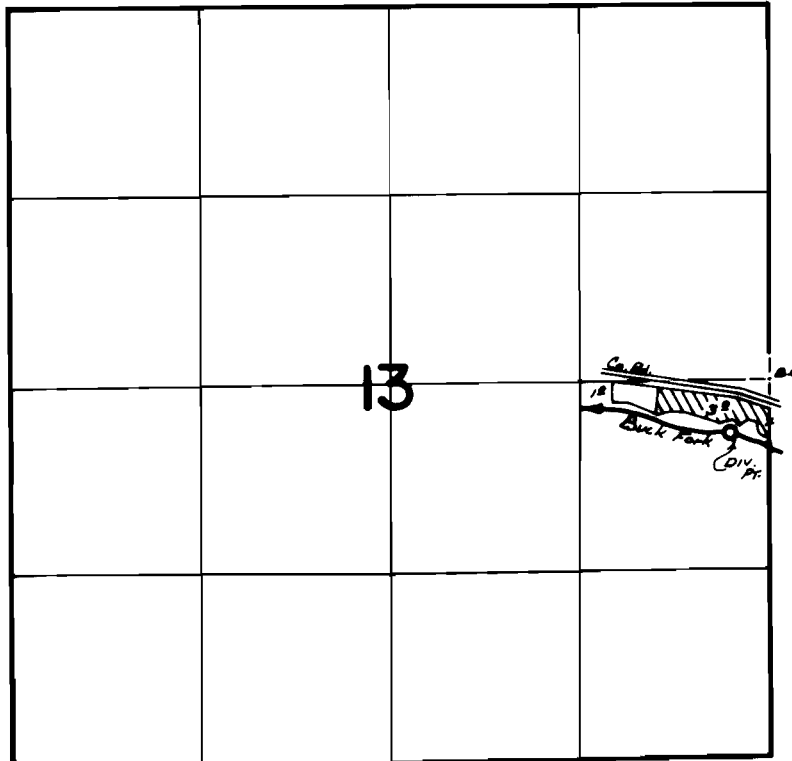

Div. Pt. Loc: 360 ft. S. and 270 ft. W. from the E 1/4 Cor. Sec. 13

FINAL PROOF SURVEY UNDER

Application No. 60508 Permit No. 45444
IN NAME OF

HENRY O. WOODRUFF

Surveyed Aug. 18, 1981, by L. TOLL