


T.17S., R.4W., W. M.

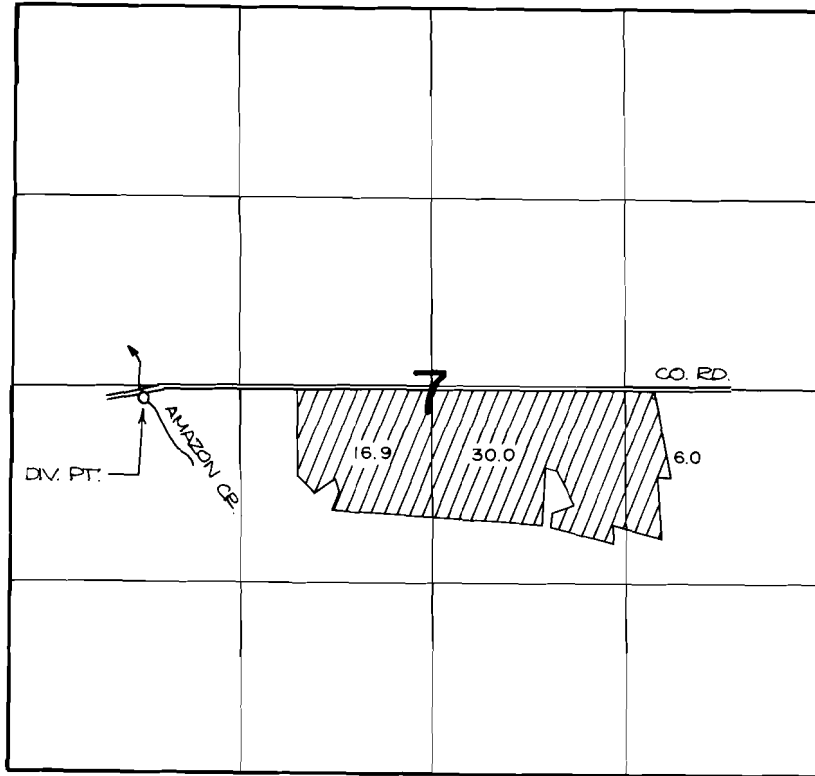

DIV. PT. LOCATION: 90 FT. S. AND 1980 FT. W. FROM THE CENTER OF SECTION 7.



FINAL PROOF SURVEY UNDER

SCALE: 4" = 1 MILE

Application No. 60284 Permit No. 45454
IN NAME OF

LOUIS L. KOKKELER

Surveyed JUNE 28, 1984, by P. Proctor