


T.13S.,R.1E.,W.M.

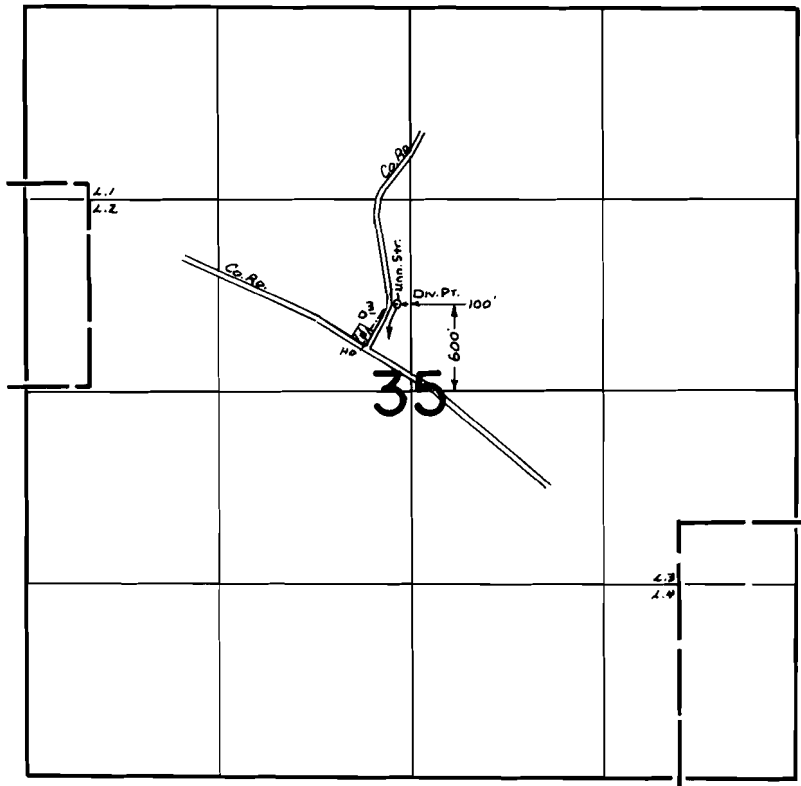

**FINAL PROOF SURVEY**  
UNDER

Application No. ..61098.. Permit No. ....45460...  
IN NAME OF

.....KATHERINE HINTON.....

Surveyed April..22.. 19.82., by ..L.M.TOLL.....