


T. 2S., R. 44& 45E., W. M.

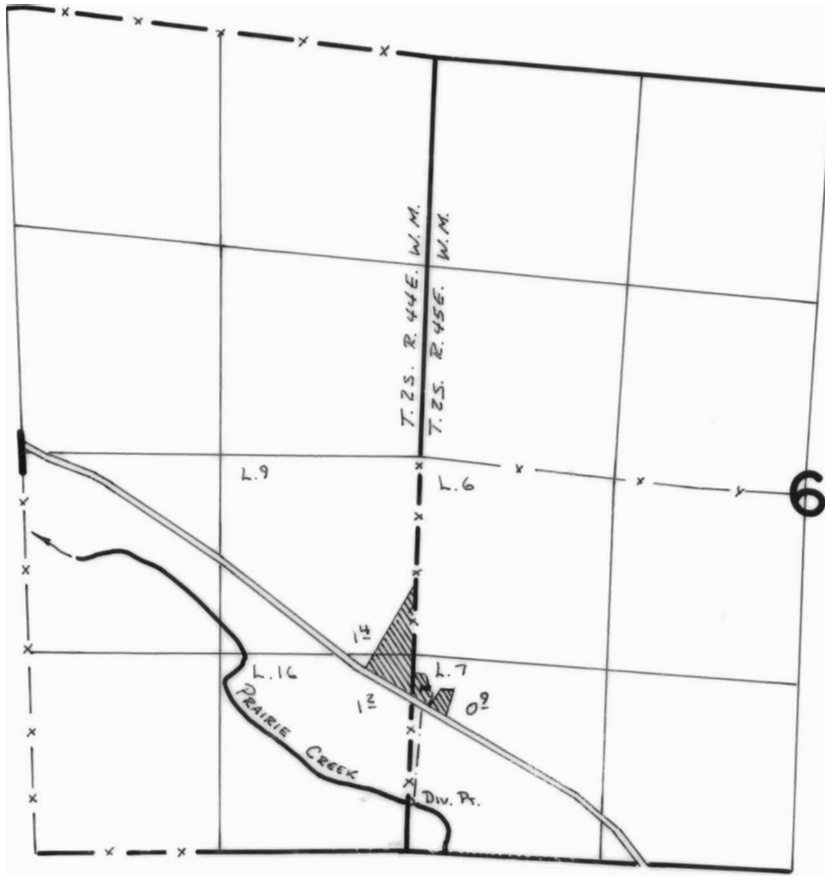

Div. Pt. Loc: 360' N. & 10' E. FROM SW COR. SEC. 6

FINAL PROOF SURVEY
UNDER

Application No. **61052**... Permit No. **45471**....
IN NAME OF

.....**DONALD E. KOOCH**.....

Surveyed ...**8:6**..... **1984**., by **K.L. Church**.....



SCALE: 1" = 400'