



# T. 36S., R. 6W., W.M.

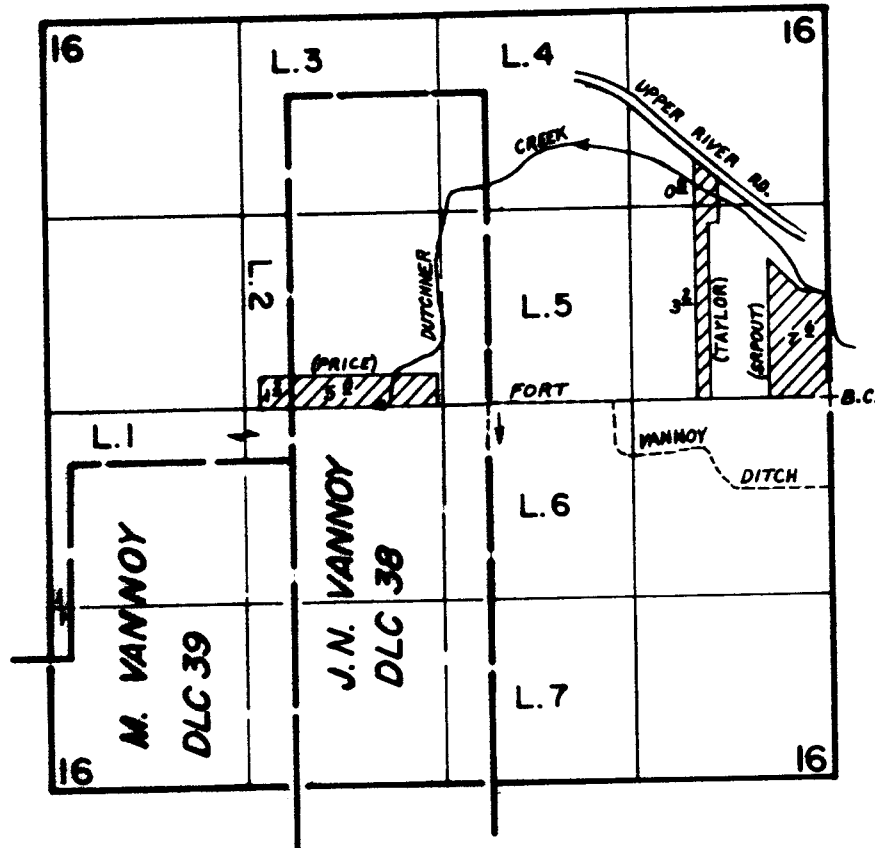

RECORDED  
 AUG 23 1989  
 THE DIST. TO  
 BE MADE BY THE  
 SURVEYOR

SCALE: 1" = 1320'

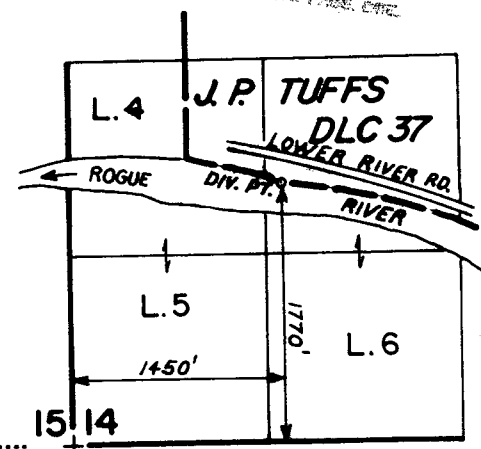

## FINAL PROOF SURVEY UNDER

Application No. 61009 Permit No. 45478  
 IN NAME OF

FORT VANNOY IRRIGATION DIST.

Surveyed JAN. 24 1984, by B. S. JAMES