


T.29S. R.4W. W.M.

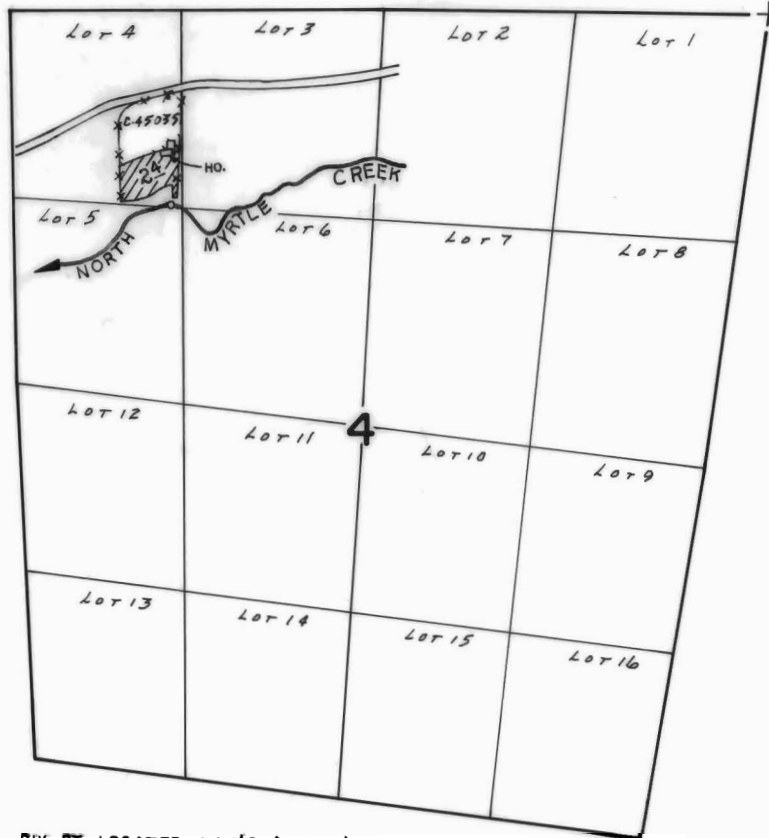

DIV. PT. LOCATED 1,310'S. & 4,110' W. FROM N.E. CORNER SECTION 4
SCALE: 4" = 1 mile

FINAL PROOF SURVEY UNDER

Application No. 61066. Permit No. 45489....
IN NAME OF

.....**WILLIAM J. BOWMAN**.....

Surveyed OCT. 5, 1983, by L. CASHION.