


T. 3 S., R. 2 W., W.M.

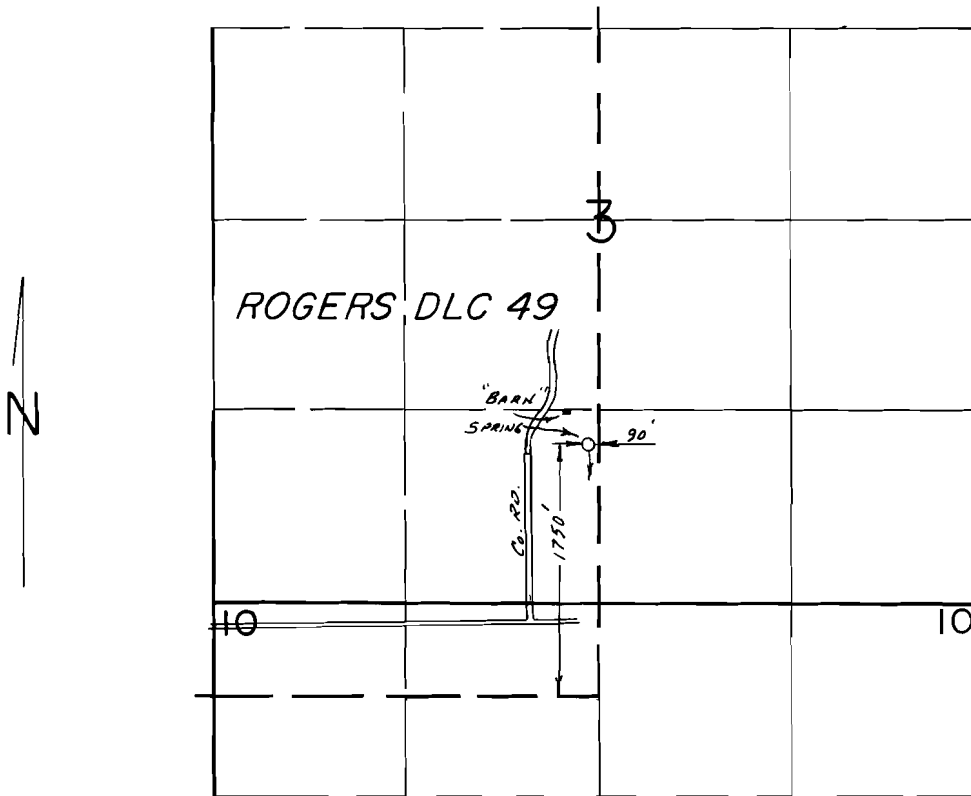

SCALE: 1" = 1320'

FINAL PROOF SURVEY UNDER

Application No. 60977. Permit No. 45512.....
IN NAME OF

.....DAVID SPRECHER.....

Surveyed Nov. 23. 1987, by B.W. BISHOP.....