


T. 17 S., R. 6 W. WM.

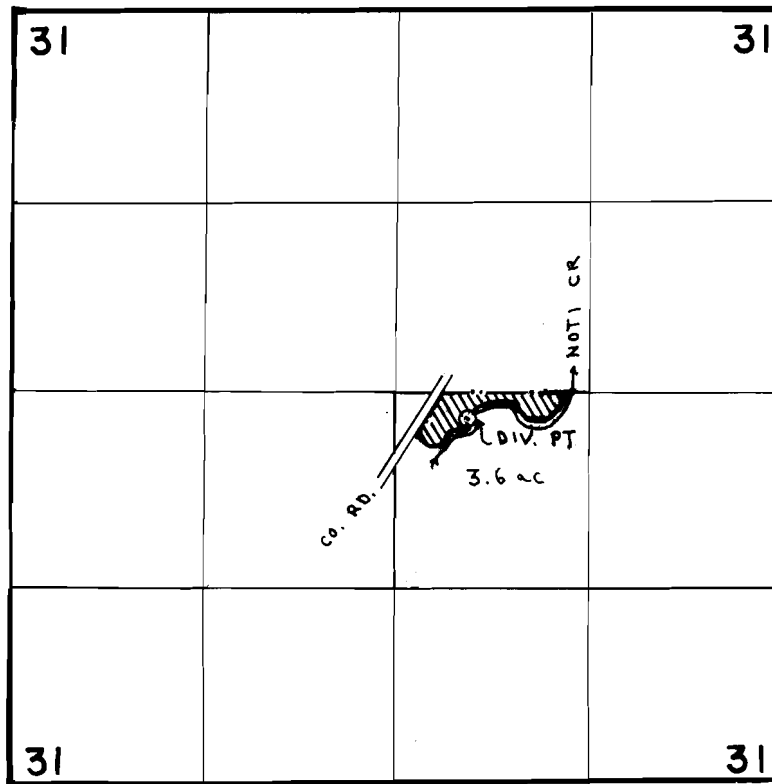

DIV. PT. LOC.: 180' S. & 500' E. OF CENTER SEC. 31

FINAL PROOF SURVEY
UNDER

Application No. 61258... Permit No. 45514.....
IN NAME OF

.....FRANK GRECO.....

Surveyed NOV. 17, 1983, by P. PRAGTER.....