


T.7S.,R.48E.,W.M.

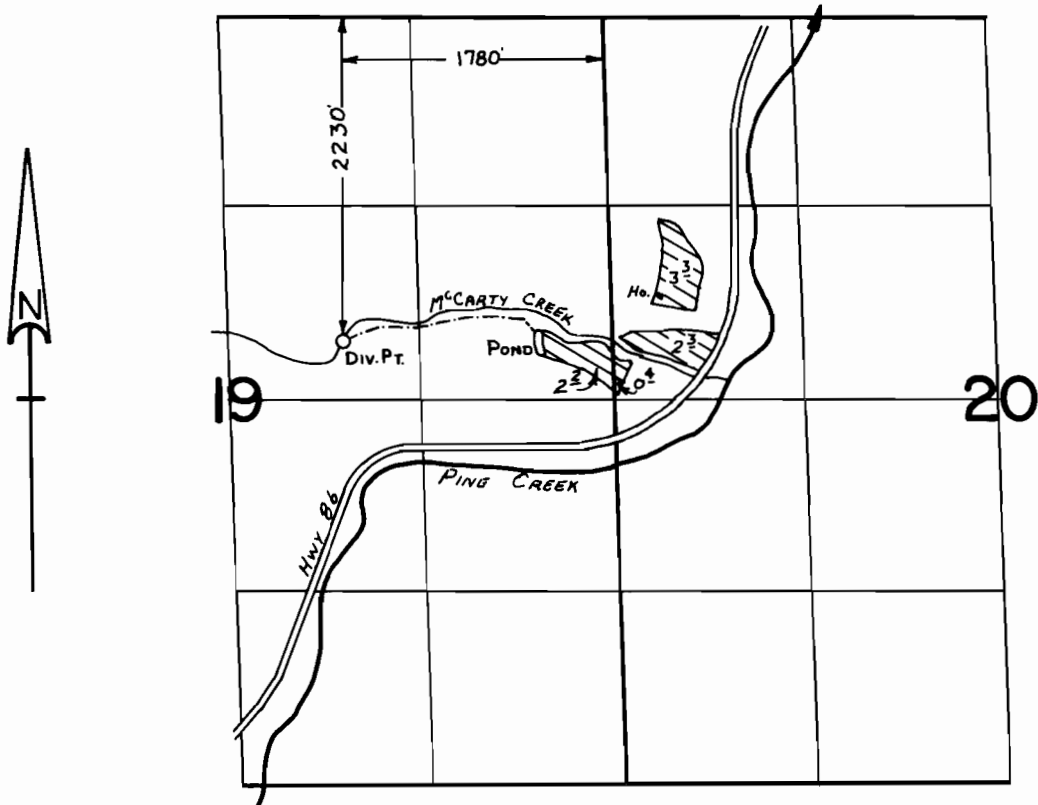

SCALE: 1" = 1320'

FINAL PROOF SURVEY UNDER

Application No. 60198.. Permit No. 45523.....
IN NAME OF

.....GEORGE P. PARKER.....

Surveyed Aug. 6.... 19.85., by L. M. TOLL.....