



T.14S., R.4W., W.M.

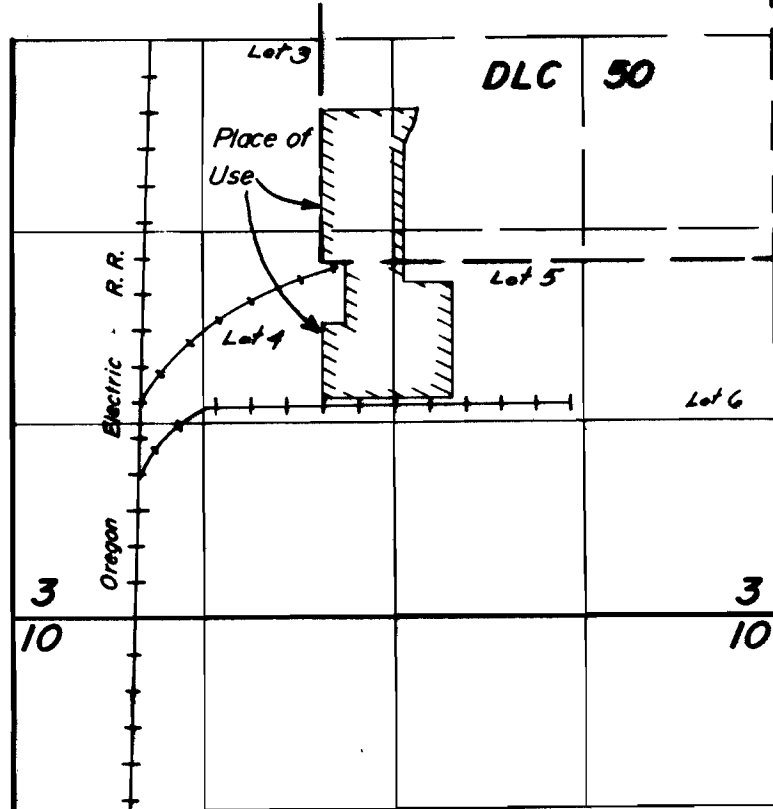

T.13S., R.4W., W.M.

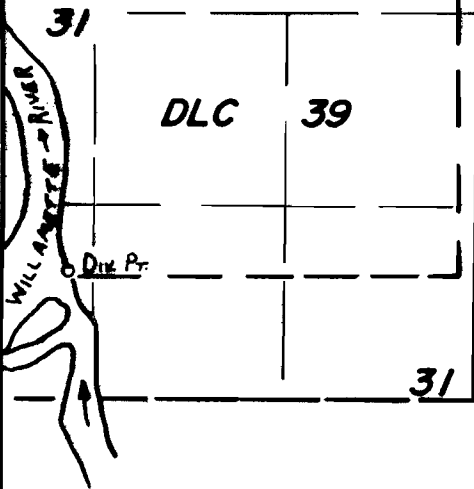

Dix Pt. Loc.: 50' N. & 2680' W. from SE Cor. DLC 39.

Scale: 1" = 1320'
FINAL PROOF SURVEY
UNDER

Application No. 61089 Permit No. 45573
IN NAME OF

HALSEY PULP CO.

Surveyed July...12... 19.84., by L. Toll.....