


T. 11 S., R. 6 W., W. M.

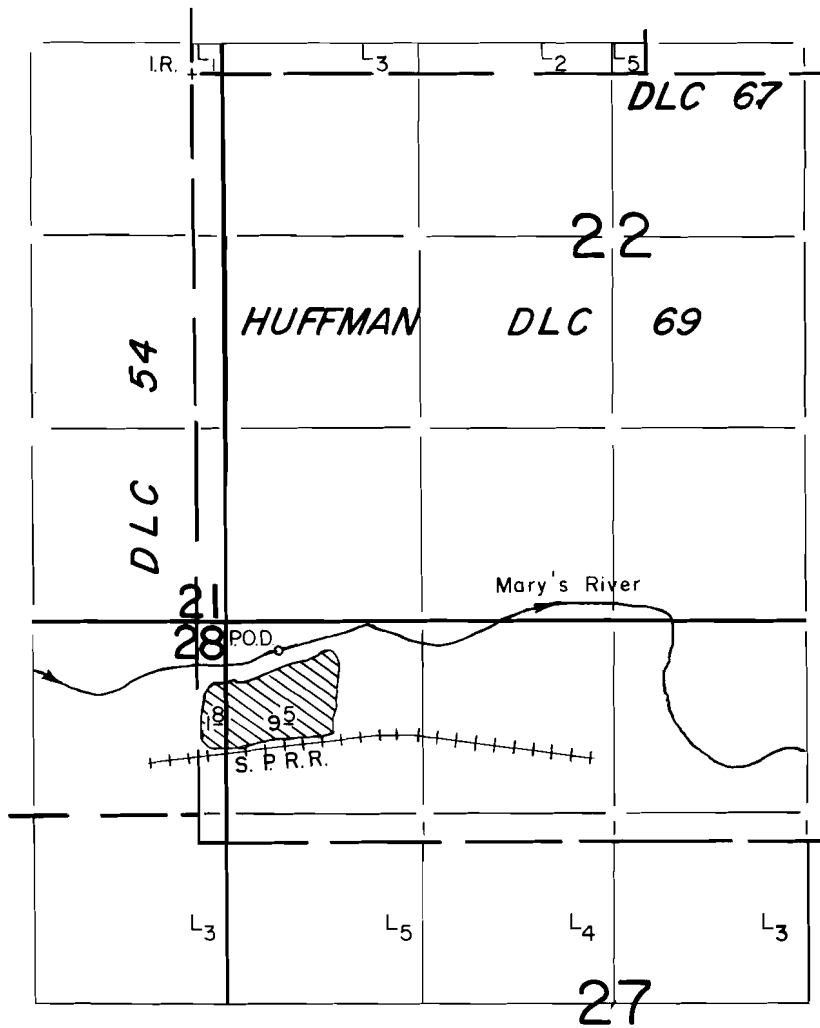

P.O.D. Loc. : 3950' S. & 550' E. from NW Cor. DLC 69.

Scale : 1" = 1320'

**FINAL PROOF SURVEY**  
UNDER

Application No. 61117 Permit No. 45574  
IN NAME OF

WILLIAM G. DOUGHERTY & T. DAWN PARKS

Surveyed Sept. 8 1988, by T. Warren