


T. 37 S.  
R. 5 & R. 6 W., W. M.

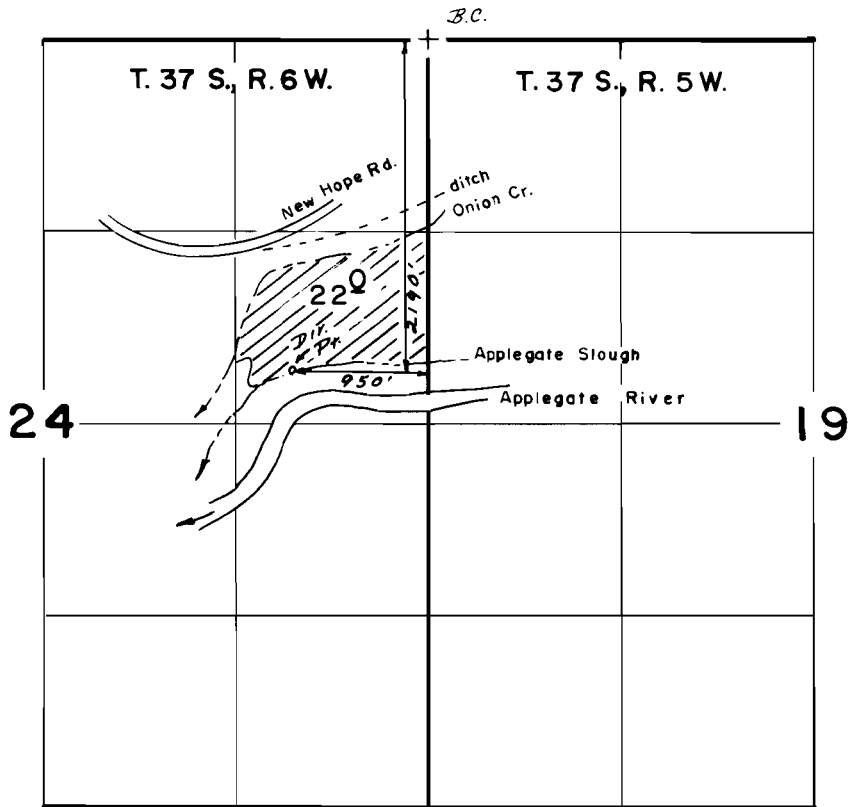

Scale: 1" = 1320'

**FINAL PROOF SURVEY**  
UNDER

Application No. 60205 Permit No. 45597  
IN NAME OF

JOHN T. BRIGGS

Surveyed AUG. 14. 1986, by B. S. JAMES