


T. 36 S., R. 4 W., W.M.

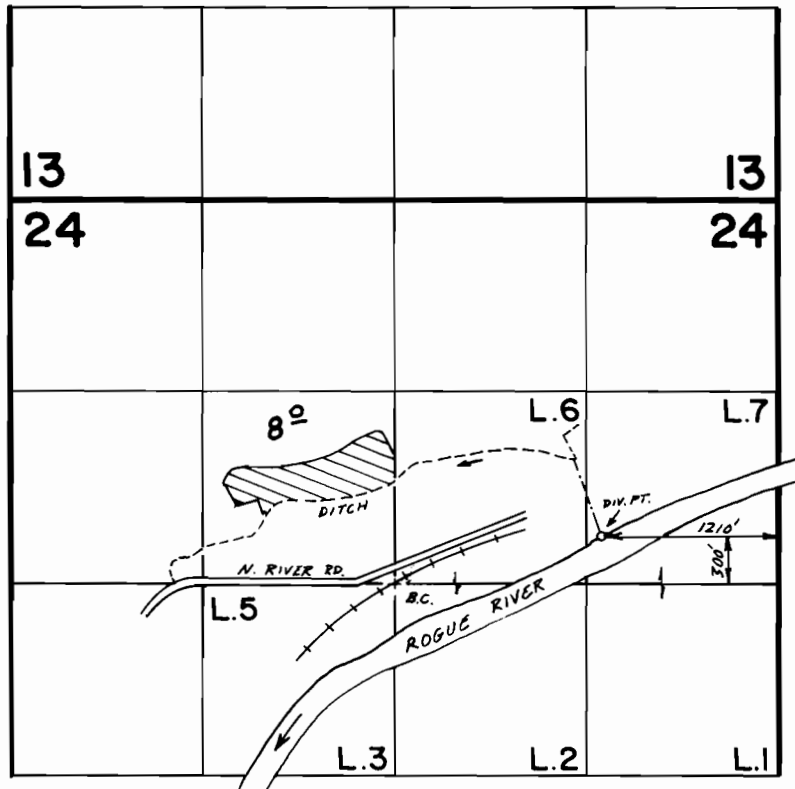

Scale 1" = 1320'

**FINAL PROOF SURVEY**  
UNDER

Application No. **60340**. Permit No. **45598**.....  
IN NAME OF

.....**ROBERT D. MURPHY**.....

Surveyed **July 3, 1986**, by **B.S. JAMES**.....