


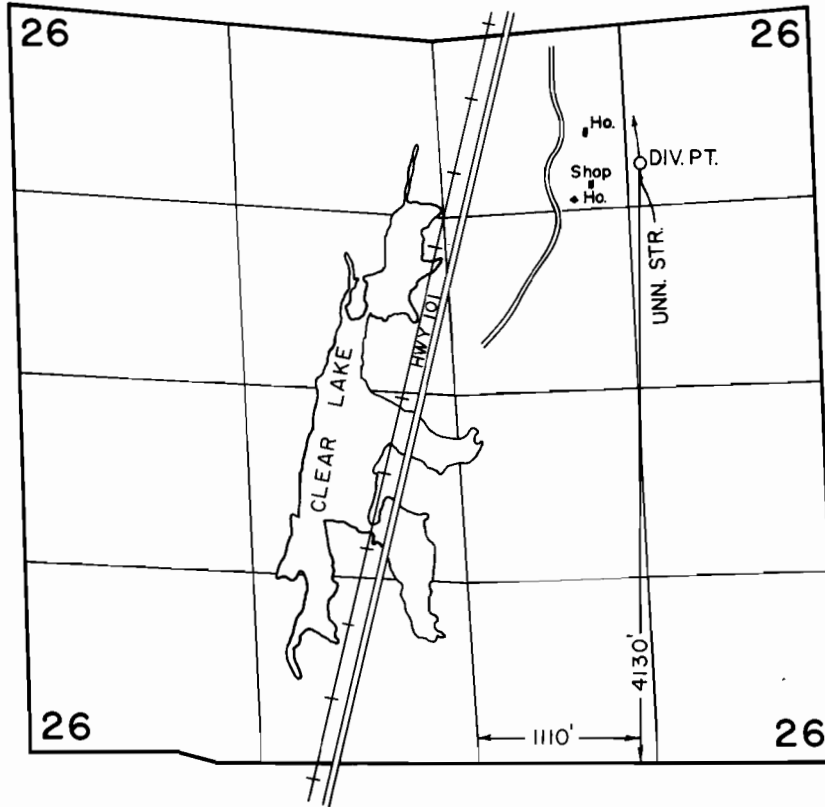

T. 23 S., R. 13 W., W.M.



SCALE: 1" = 1320'

FINAL PROOF SURVEY
UNDER

Application No. 60369.. Permit No. 45666.....
IN NAME OF

PAUL F. & ERMA R. McALISTER

Surveyed SEPT. 17. 1988., by V. L. CHURCH.....