


T. 3 S., R. 3 W., W. M.

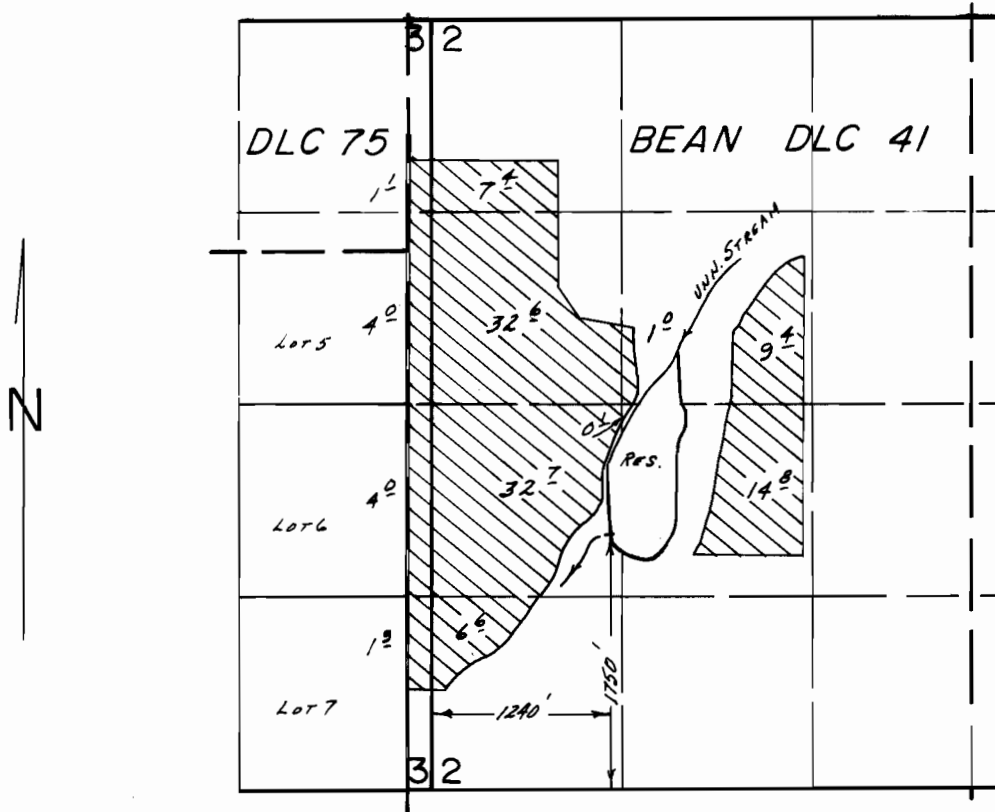

SCALE: 1" = 1320'

**FINAL PROOF SURVEY**  
UNDER

Application No. 63105... Permit No. 46315.....  
IN NAME OF

BAILEY NURSERIES, INCORPORATED

Surveyed Sept. 24 19.87, by B.W. BISHOP.

3/15/89  
AWB

41071-170-1346