


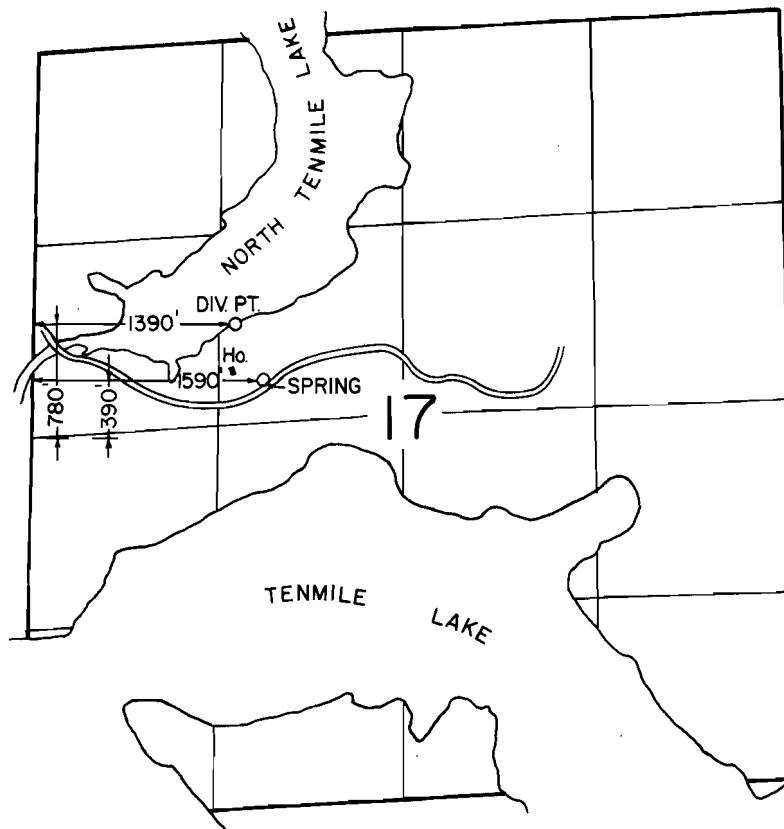

T. 23 S., R. 12 W., W.M.



SCALE: 1" = 1320'

FINAL PROOF SURVEY UNDER

Application No. 62143 Permit No. 46360
IN NAME OF

JOHN I. & EVELYN M. MANGUM

Surveyed SEPT. 19 1988, by L. M. JOACHIMS