


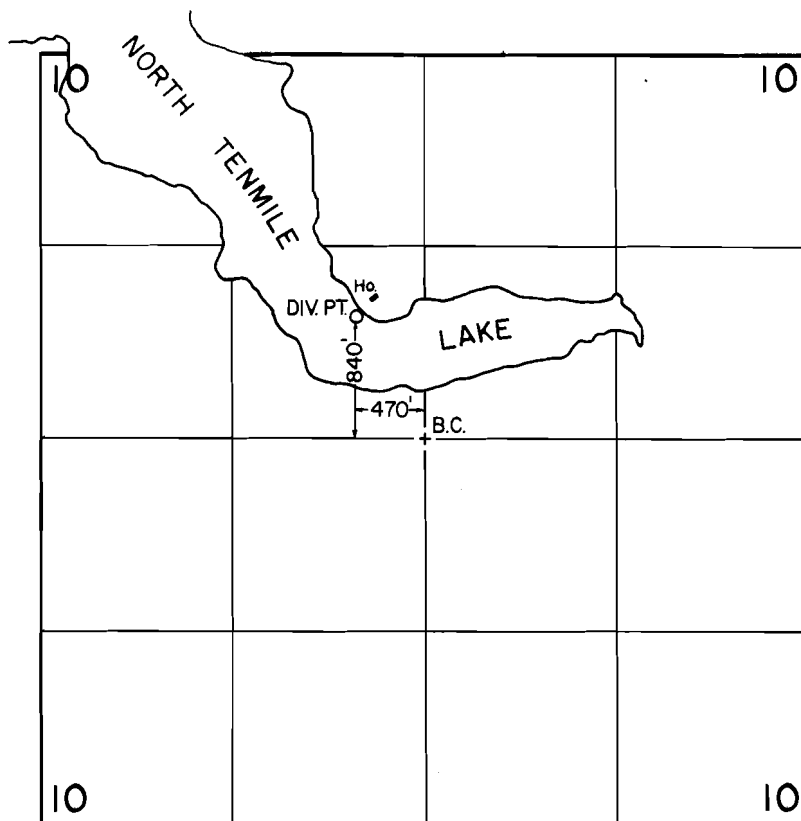

T. 23 S., R. 12 W., W.M.



SCALE: 1" = 1320'

FINAL PROOF SURVEY

UNDER

Application No. 62953... Permit No. 46894...
IN NAME OF

LLOYD A. BROWN

Surveyed SEPT. 20 1988., by T. M. WARREN...