


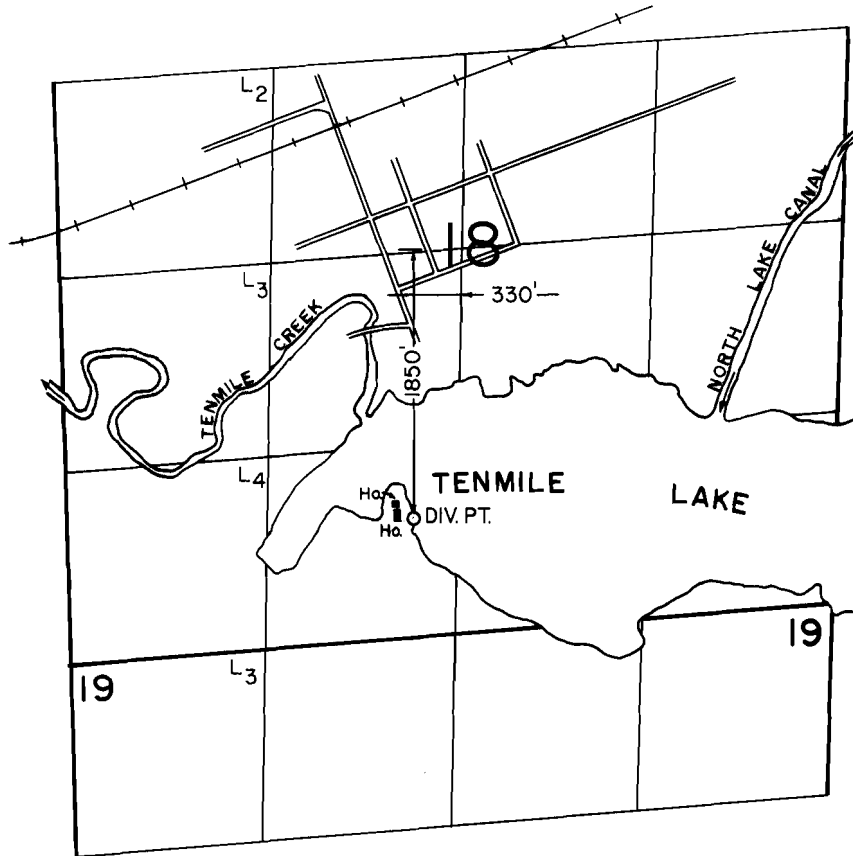

T. 23 S., R. 12 W., W.M.



SCALE: 1" = 1320'

**FINAL PROOF SURVEY**  
UNDER

Application No. 63806. Permit No. 47039  
IN NAME OF

PHILLIP DREHMER

Surveyed SEPT. 19. 1988., by L. M. JOACHIMS