


T. 6S., R. 5W., W.M.

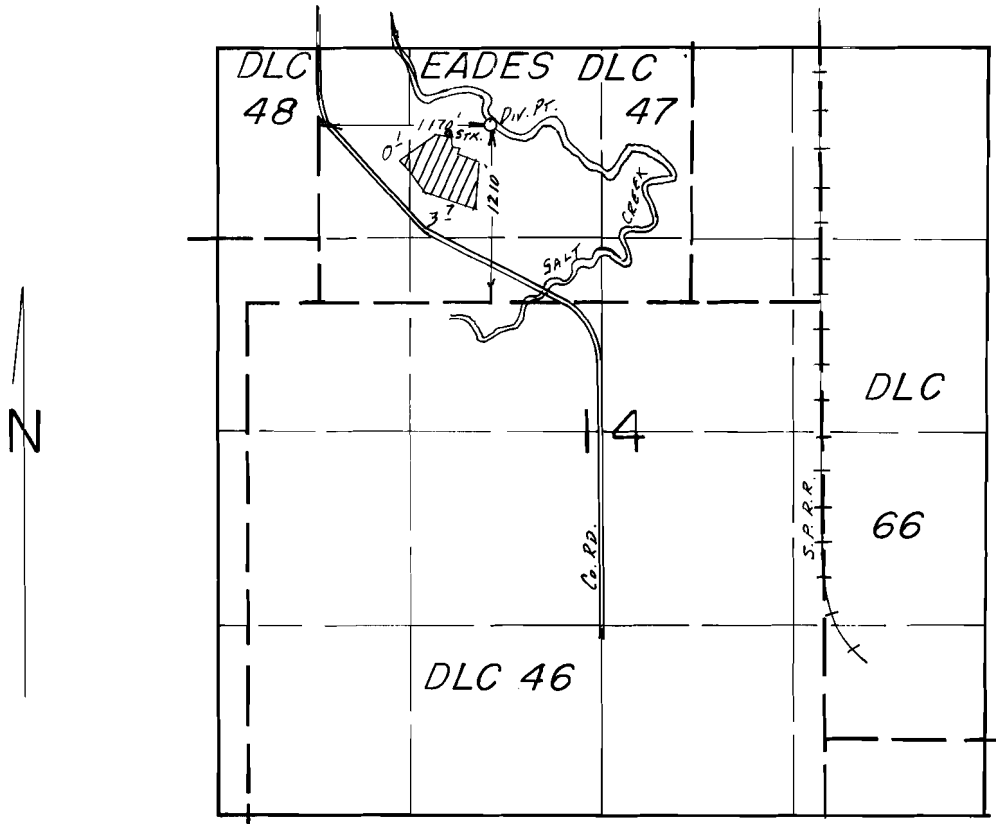

SCALE: 1" = 1320'

FINAL PROOF SURVEY
UNDER

Application No. 65574.. Permit No. 47671.....
IN NAME OF

.....ROBERT TRACEY.....

Surveyed April 28, 1987, by B.W. BISHOP.....

PTS 1987B 3/20/89 BWB