


T. 13S., R. 5W., W.M.

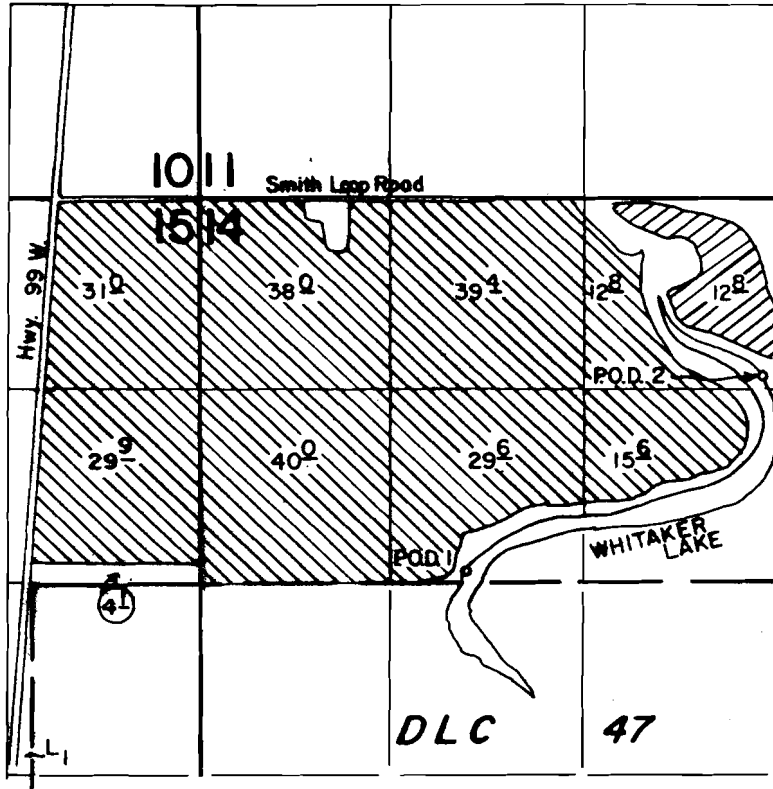

P.O.D. 1 Loc. : 2550' S. & 780' W.
 P.O.D. 2 Loc. : 1200' S. & 1250' E., both from N 1/4 Cor. Sec. 14.

Scale: 1" = 1320'

FINAL PROOF SURVEY UNDER

Application No. 68083... Permit No. 48489.....
 IN NAME OF

T. A. & JUDY WARDEN

Surveyed Sept. 8, 1988, by T. Warren

41003-178-46R
 3/15/09 TWW