


T. 5S., R. 4W., W.M.

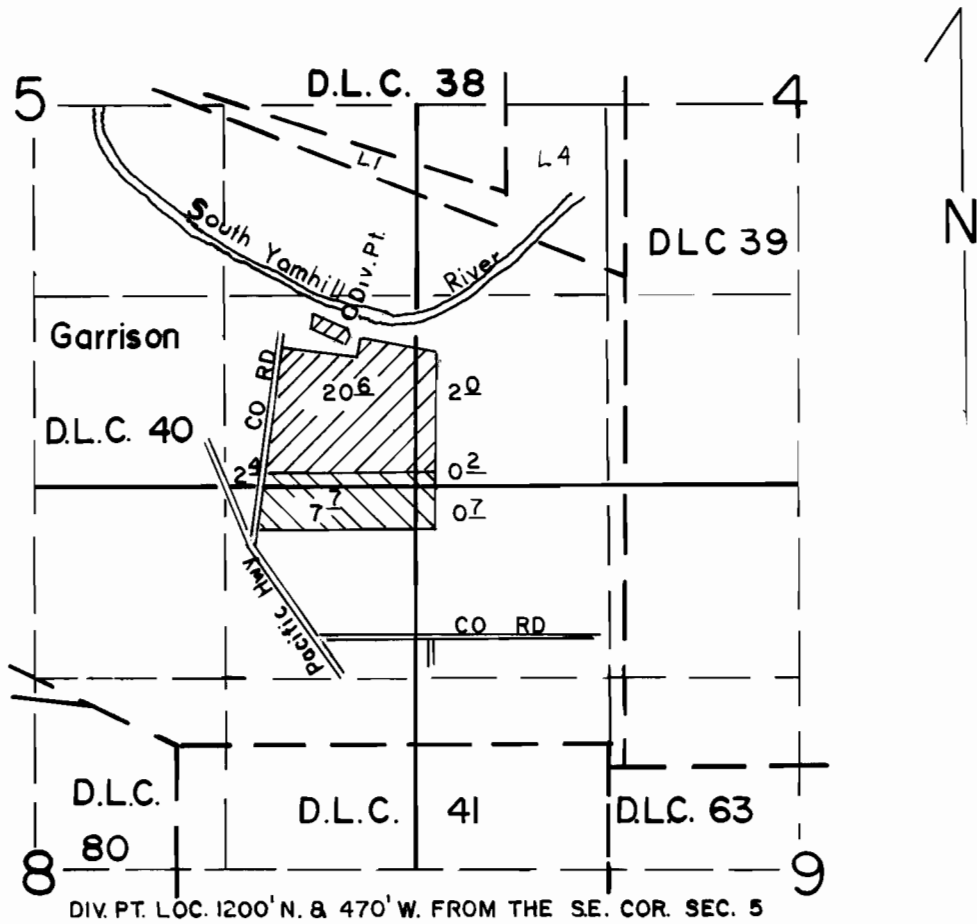

SCALE: 1" = 1320'

FINAL PROOF SURVEY
UNDER



Application No. 68123... Permit No. 48753.....
IN NAME OF

.....ALVIN WEIRICH.....

Surveyed AUG. 14. 1987., by B.W. BISHOP.....