


# T. 14S., R. 5W., W.M

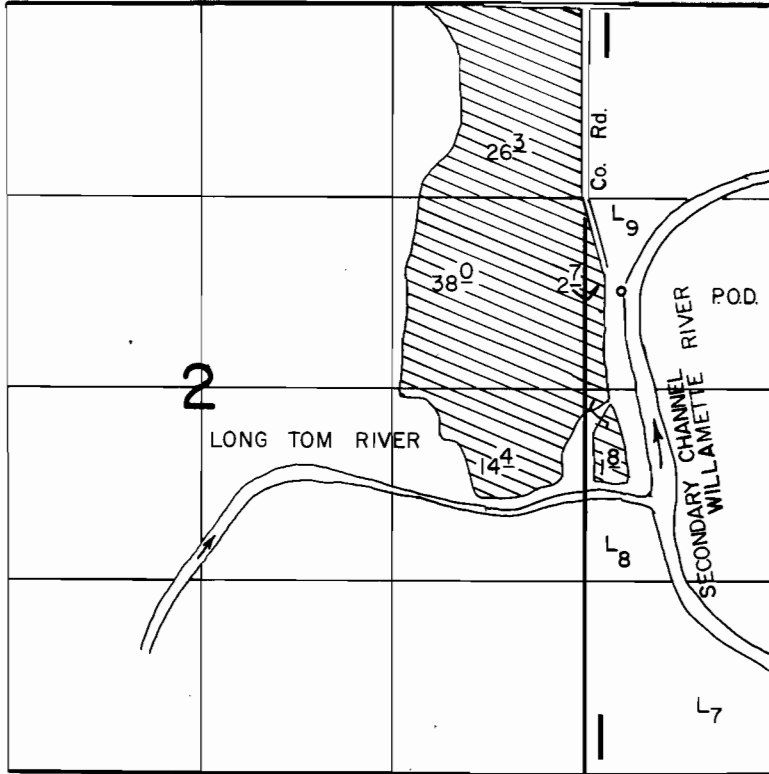

P.O.D. Loc.: 1950' S. & 250' E. from NE Cor. Sec. 2.

Scale : 1" = 1320'

## FINAL PROOF SURVEY UNDER

Application No. 65084. Permit No. 47569.....  
IN NAME OF

RAY TRENHOLM

Surveyed Sept. 25, 1987, by T. Warren.....